35+00 ◎

35+28 Enter Swamp Rd Mosquito creek

B 35

38+31½ ◎

100± ft set Hub for curve 2nd pt
over ~~Rd~~ Took Sta 43+25 90° R & distant
at Sta 46+28 on ake Hse) thence Inst
chained west 303± (could not offset
main line (west) on track ½ way between rails
N+RR's. main line. thence with R.S. Com
North & set tack in tie ½ way between rails
not on tee line between 39+30 angle Lt &
line 2nd pt of R.S. on Hub 076 South of
Inst over Sta 46+28 set Hub on ℄
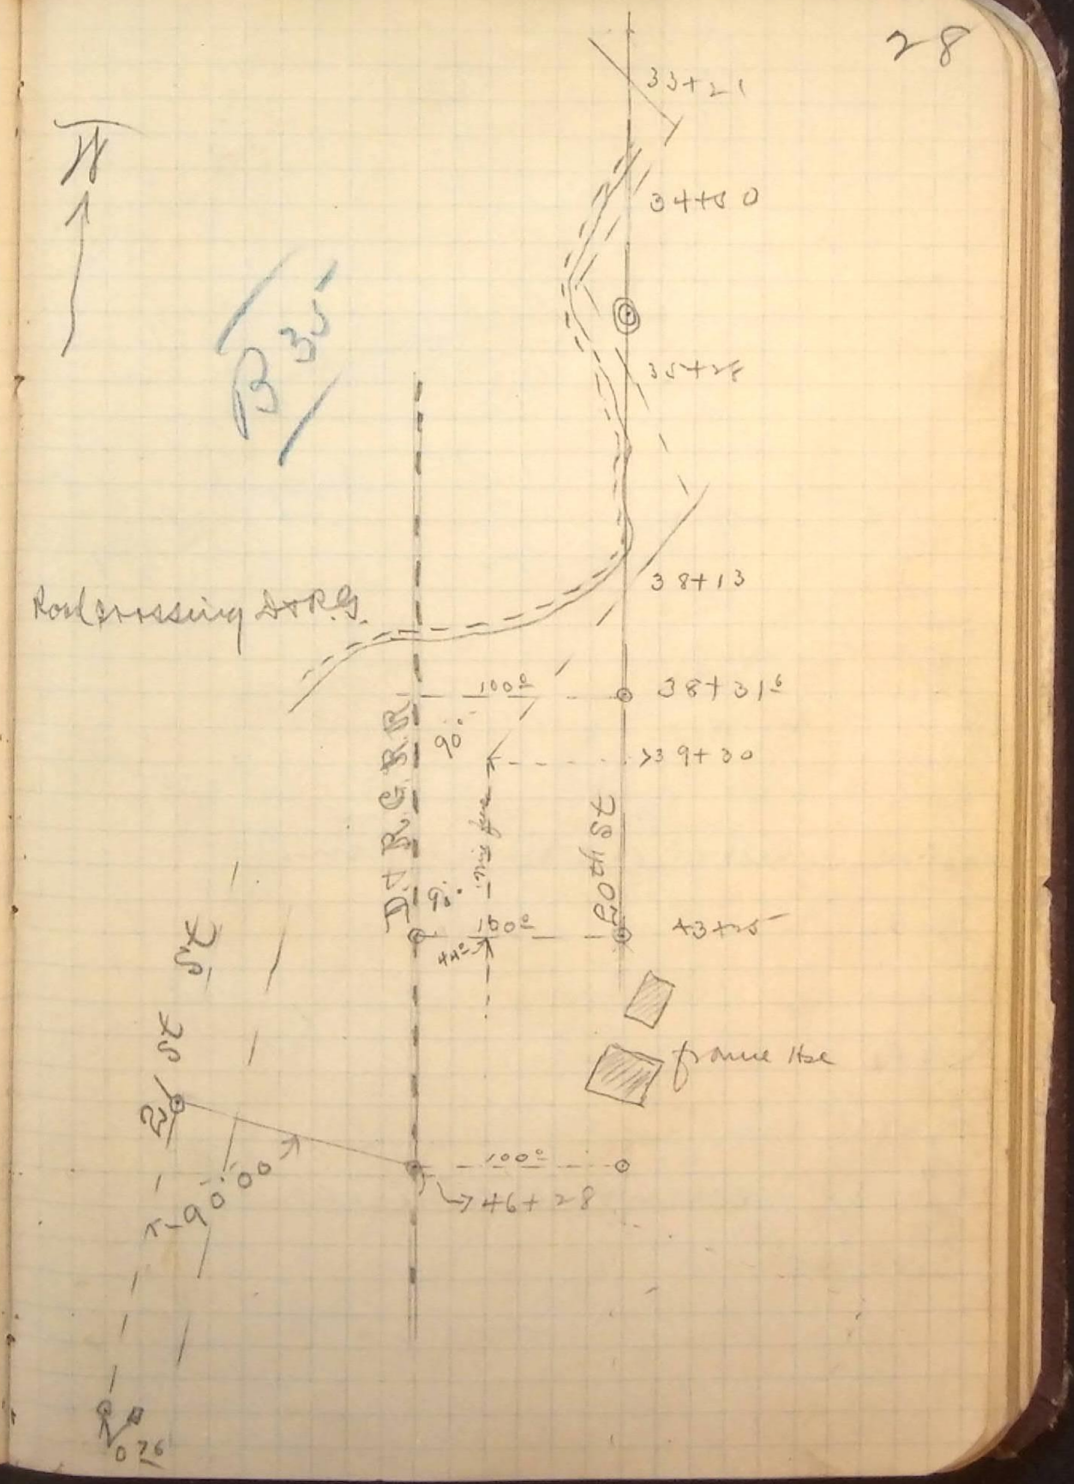
Continued from Page 27