See Page 50

Tie chipped

35+36.95 = Chisel point on S.E. G rail D.&R.G.

40+00 = Hub

46+27.03 = Hub

49+79 = Ditch

50+00 = Hub

51+73 = West " " "

51+83 = East Edge P.C. Canal

(Note: nothing to be gained by changing channel)

51+89 = Hub set to meander P.C. Canal from line 21st St - see diagram

Thence 90° R.F.L. onto 15° offset north center

PM

54+49.61 = Hub 15.76 South of mt

54+95.2 = West " " "

55+05 = East " " "

55+41 = West " S "

55+49 = East " " "

55+93.6 = West " "

55+97 = East rail N.G.

56+65.2 = West rail
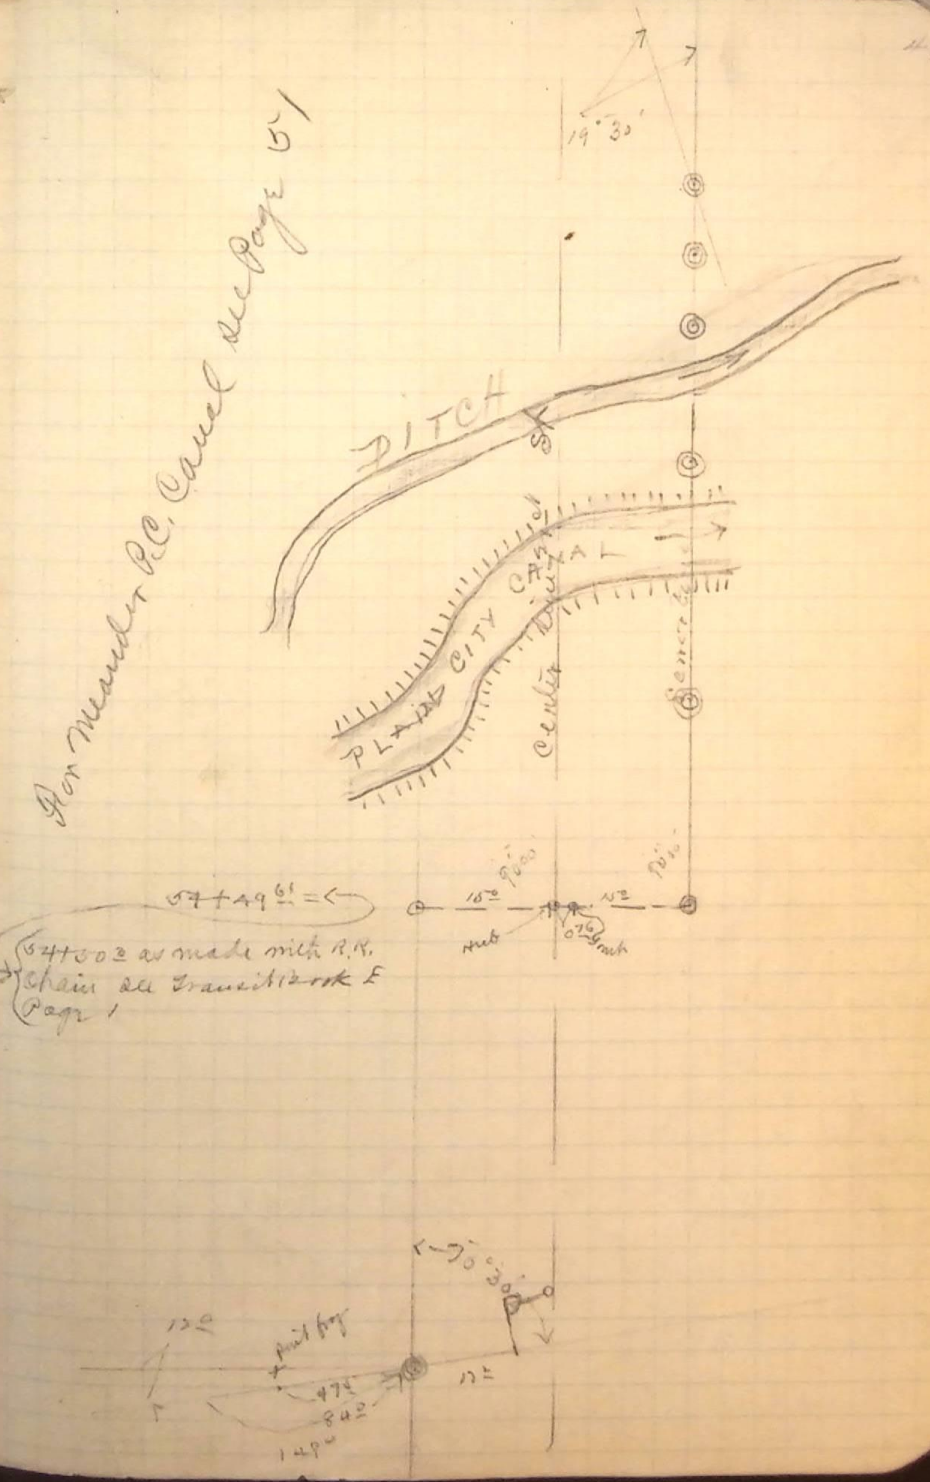
56+70.2 = East rail point on rail