

22+00 = east water edge water R cut


20+00 = Hub

with ~~100~~ and 100' north of the center thereof

32+79.68 = Hub angle 19' 30" In + West parallel

Main Outlet Sewer continued from page 49

Thursday Aug. June 26th 1890

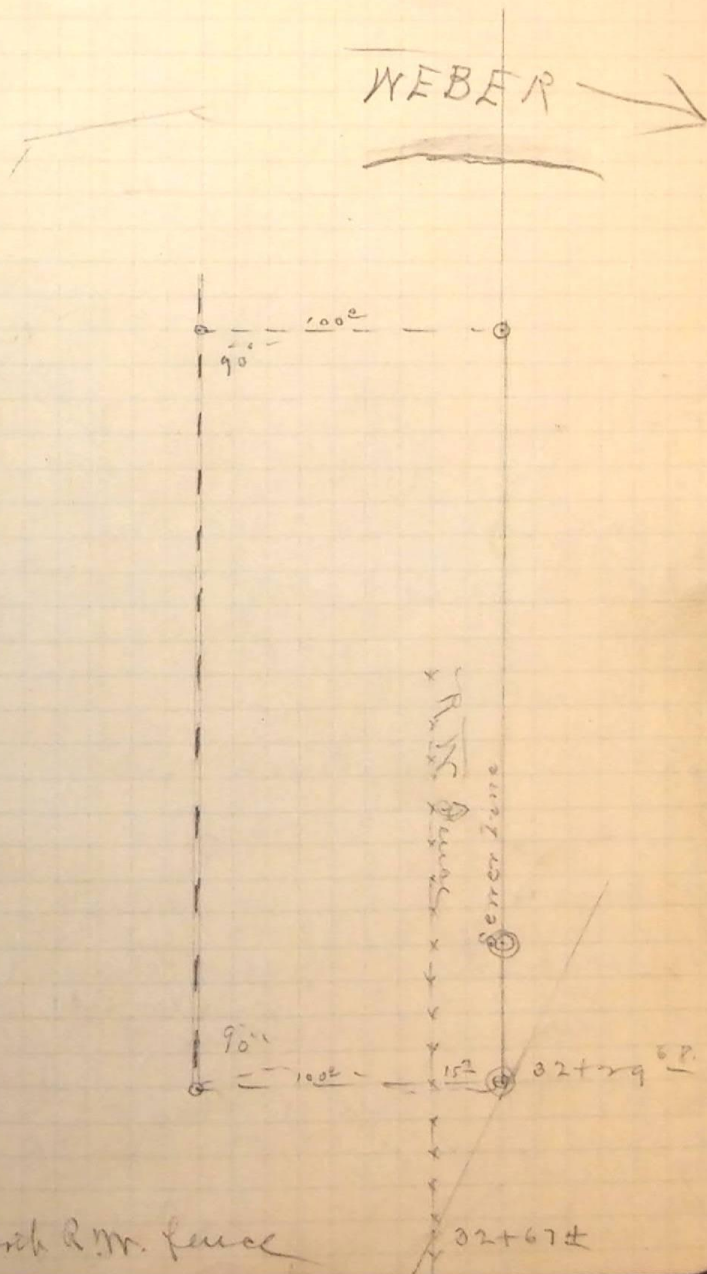

cross with R.M. fence

32+67±