Location of Railways etc on
Cor 25th & Washington Ave,
May 5 1890. P.M.

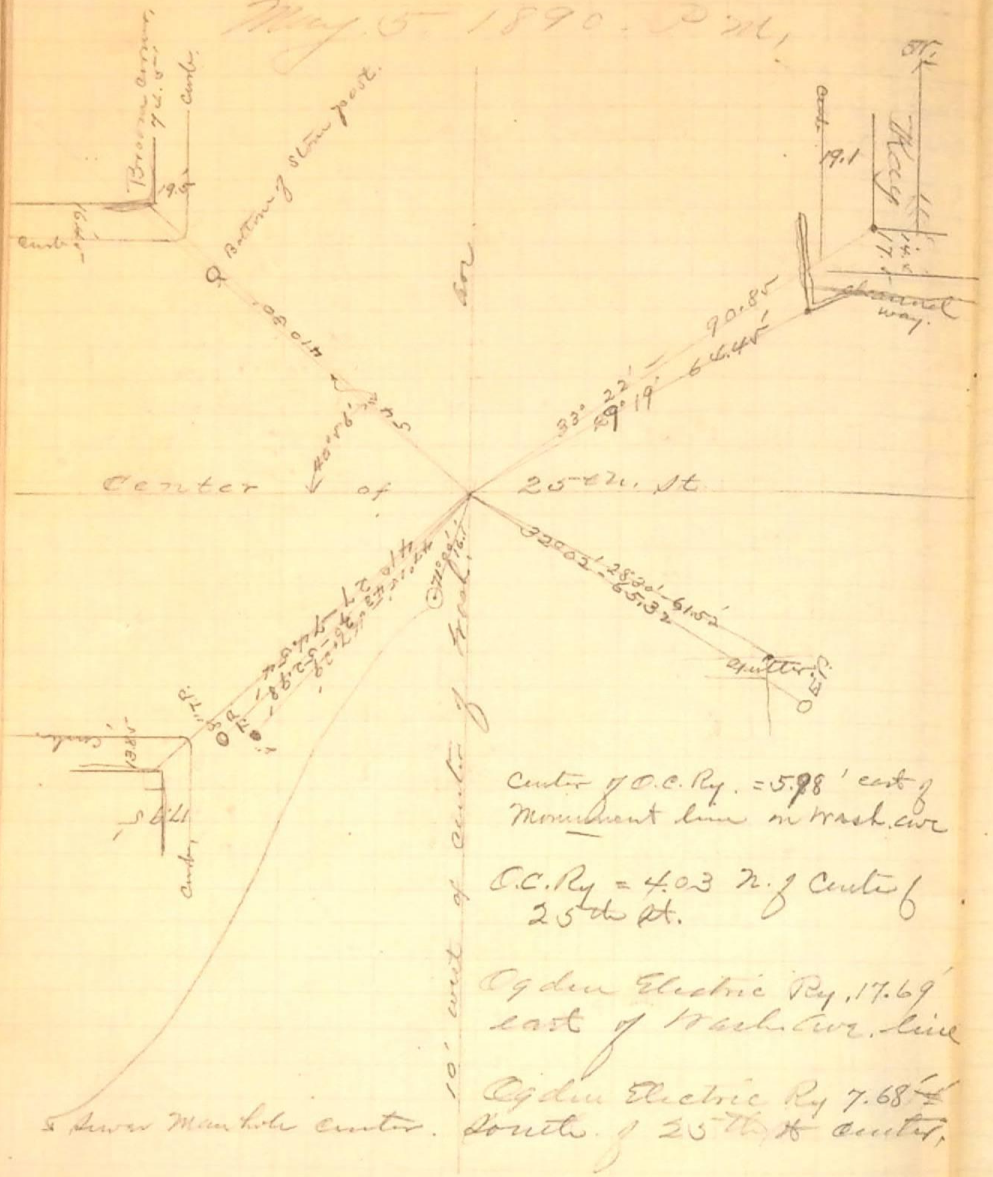

Center of O.C. Ry. = 5.98' east of Monument line on Wash. ave

O.C. Ry = 4.03 N. of Center of 25th St.

Ogden Electric Ry. 17.69' east of Wash. Ave. line

Ogden Electric Ry 7.68' ± South of 25th St center,

The angles given are all north or south from an east & west line as my foresight was at intersection of 25th & Grant ave.