

see page 18 this book for trees
 + Grant as it had been removed
 did not plant mt at 27th
 afterwards planted mt # 86 Lincoln
 Lincoln + Grant avenues.

sected hubs previously set at
 25th on mt # 2 Grant + 27th and Inter-
 stance. Just over mt # Hall + 27th

of 27th

25th and set hubs either side center line

and 27th 25th on mt # 10 Lincoln and

there just over mt # Lincoln

either side center line 27th st

Don mt # Grant + 27th + set hubs

Just over mt # Grant + 27th

planting monuments


B34

by intersection preparatory to

and Lincoln avenues and 27th st

Establishing the center of Grant

Friday P.M. May 16th 1890

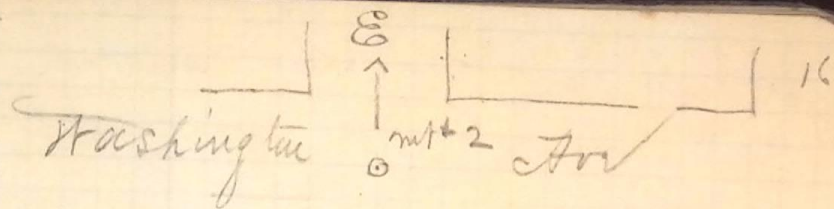

see page 18 this book for trees
 to mt # 86

