

Chaining East

168+79 = made correction of 2 1/4 + continued

= Sta 168+81 1/2 found it to be

subs just set on center line Tyler Ave

Stone #1 double centered + sub-extended

thence just over Stone #2 B.S. on

set hubs either side center line 30' at

hub B.S. on mt #22 double centered

of 30' at thence just over latter

summit of hill about 300 yd north

90° 00' L + South (repeated) + set hub

B.S. on mt #14 (medium + 2 1/4')


PM Just over mt #22 (Tyler + 2 1/4')

on Stone #2 = Sta 160+71 1/2 (corrected)

Just over Hub Sta 126+83 B.S.

B.S. mt #37

Just over Sta 126+83 (= top of well)

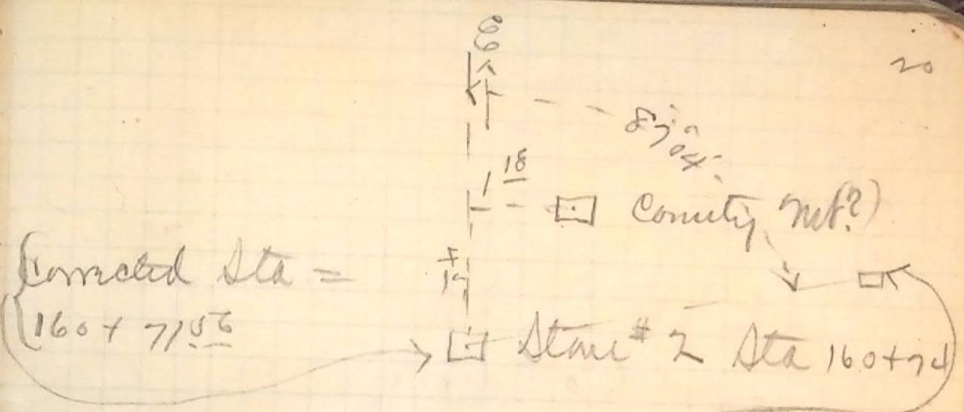

Post 4" x 4" x 3 1/2'
 N.B. Cor. B.L.C.
 addition

B.34