

180+20 = Stone # 3

180+14 = 1st fence

at 175+29 = 2nd fence

B.S. Stone # 2

Just over Hub Sta 175+00

of Tyler and So<sup>th</sup> St

6" x 8" on top & 12" deep at intersection

there Planted Blue granite Stone

at Sta 170+58 = fence re diagram


119° = No. Cur Blk 11 addition

deflection 26° 08' R. & distant

on Stone # 2 (Sta 160+71.5 = corrected)

Just over Hub Center Tyler B.S.

B.34

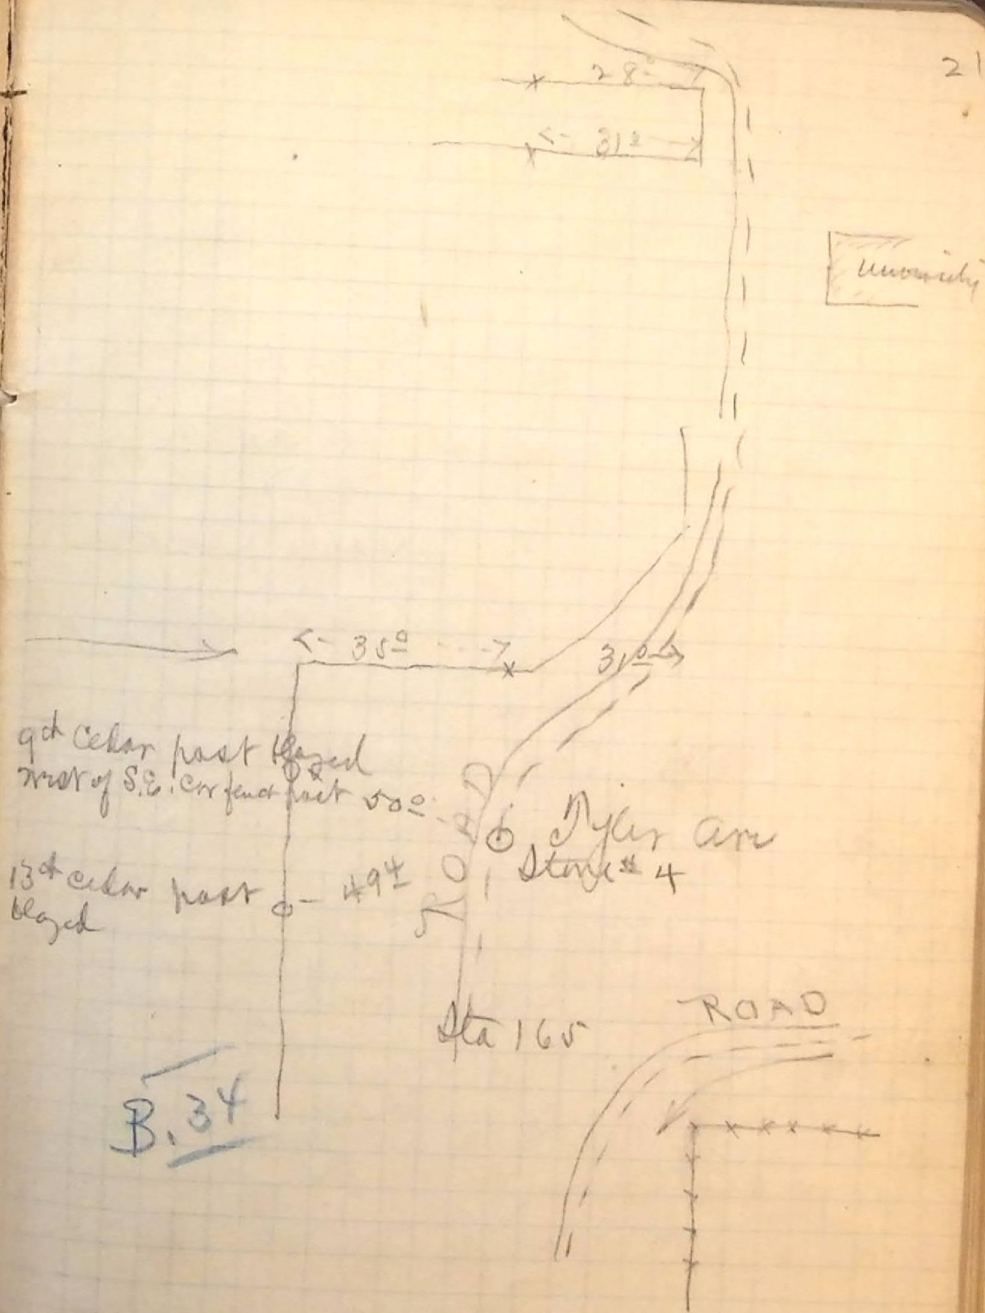

B.34