

For ties to which see <sup>also</sup> ~~Refer~~ <sup>Book</sup> ~~Book~~ <sup>Fig 25</sup>

Washington Am  
the most property line of  
Center Pincocks Lane and on  
afterwards located mt # 89

Easterly rail U.S. main track  
centered + set point on the  
P.L. Lane + Wash Am double  
P.S. on track in the center of

these just over sub sta 77+92  
of Washington Am.


Lane + on the most property line  
for mt on center line Pincocks  
set chained 66' ft + set Hub

these mt F.S. on Hub just

this Hub is about 77+92 ) B.34  
circle + set task.

No 89

Pincocks Lane

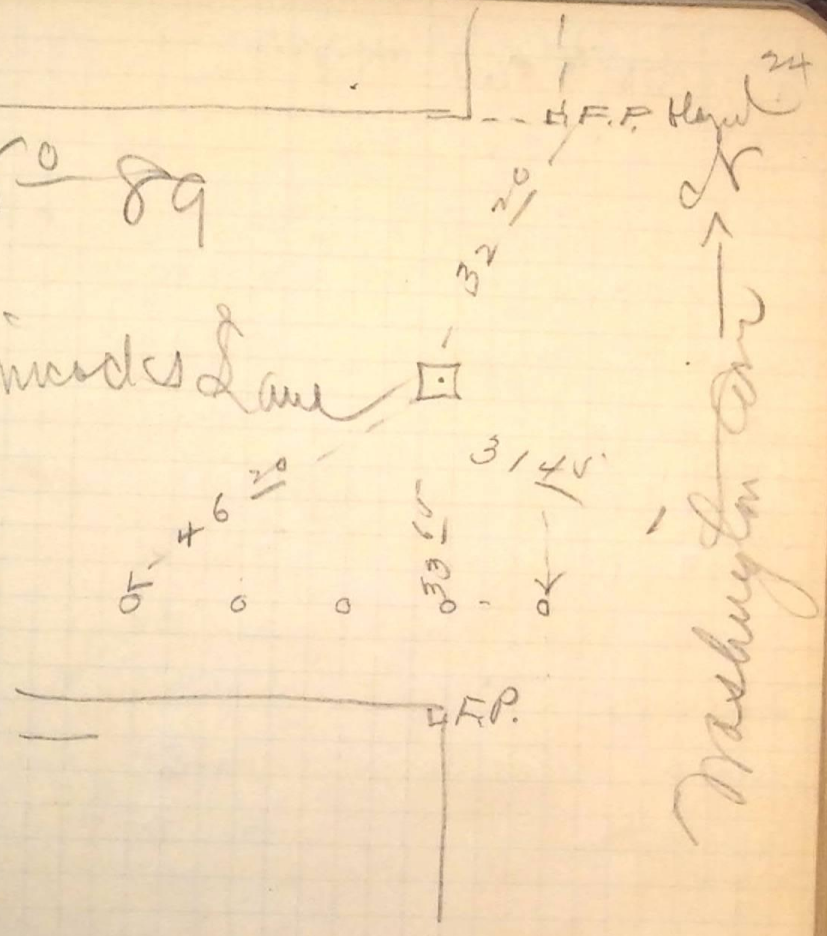

B.34