


Angles		Courses	
Left	Right	Old	Mag
250+500			
245	26° 00'	N 26 1/2 W	
241+000	28° 00'	N 1/2 W	
238+00	26° 00'	N 33 3/4 W	
237+93			
236+00	28° 00'	N 12 1/2 W	
235+17			
232+00	28° 00'	N 11° E	
230+50	26° 00'	N 12 1/2 W	
227+50	11° 30'	N 7° E	
221+700	50° 00'	N 19° E	
219+50	11° 00'	N 32° W	
219+11			
215+10			
216+53	21° 30'	N 20 3/4 W	
214+500	56° 00'	N 2° E	
210+500	41° 00'	N 57° E	
205+500	10° 00'	N 16° E	
203	48° 00'	N 21° E	
193+12			
180+700		N 7 1/2°	

Wednesday am, May 21st 1890

marked #00 previous survey (Jenkins)
25' left of our sta 250+06 = old hub

cross fence
cross stream
A.F.P.

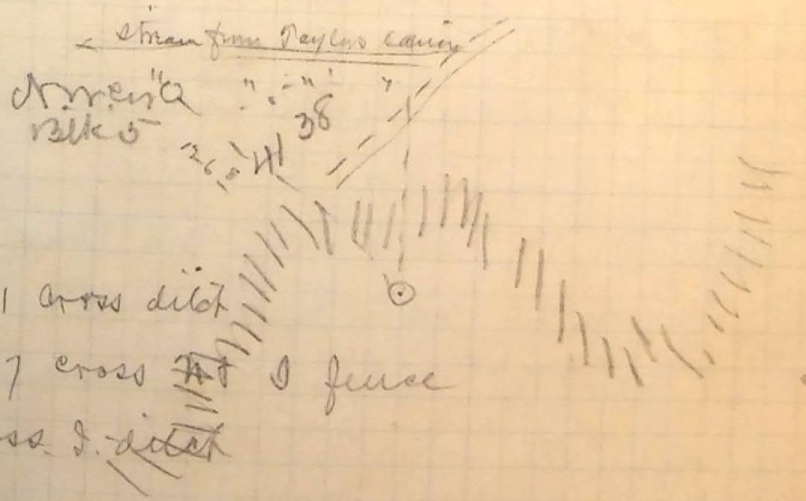

197+01 cross ditch
196+97 cross fence
cross ditch