Reuse Inst over latter Hub
it to check exactly)
took to check "plunge" of telescope final
arrows. (Needle centered when sitting
Hill 23d st returns Adams & Jefferson
lifted sight & set Hub on summit of
Reuse Inst over Mkr #12 B.S. on Mkr #6,

90° 00'
180° 00' + a hair
270° 00'
360° 01' — a little

Note: I was shook up 2 or 3 times while repeating this side took it for granted as the other side checked that it was instrumental error.

on to Mkr #12 as follows.
Mkr #8 (2d st & Wash) Angle Is & Mkr
Inst same position B.S. on

90° 00'
180° 00'
270° 00'
360° 00'

B. 35
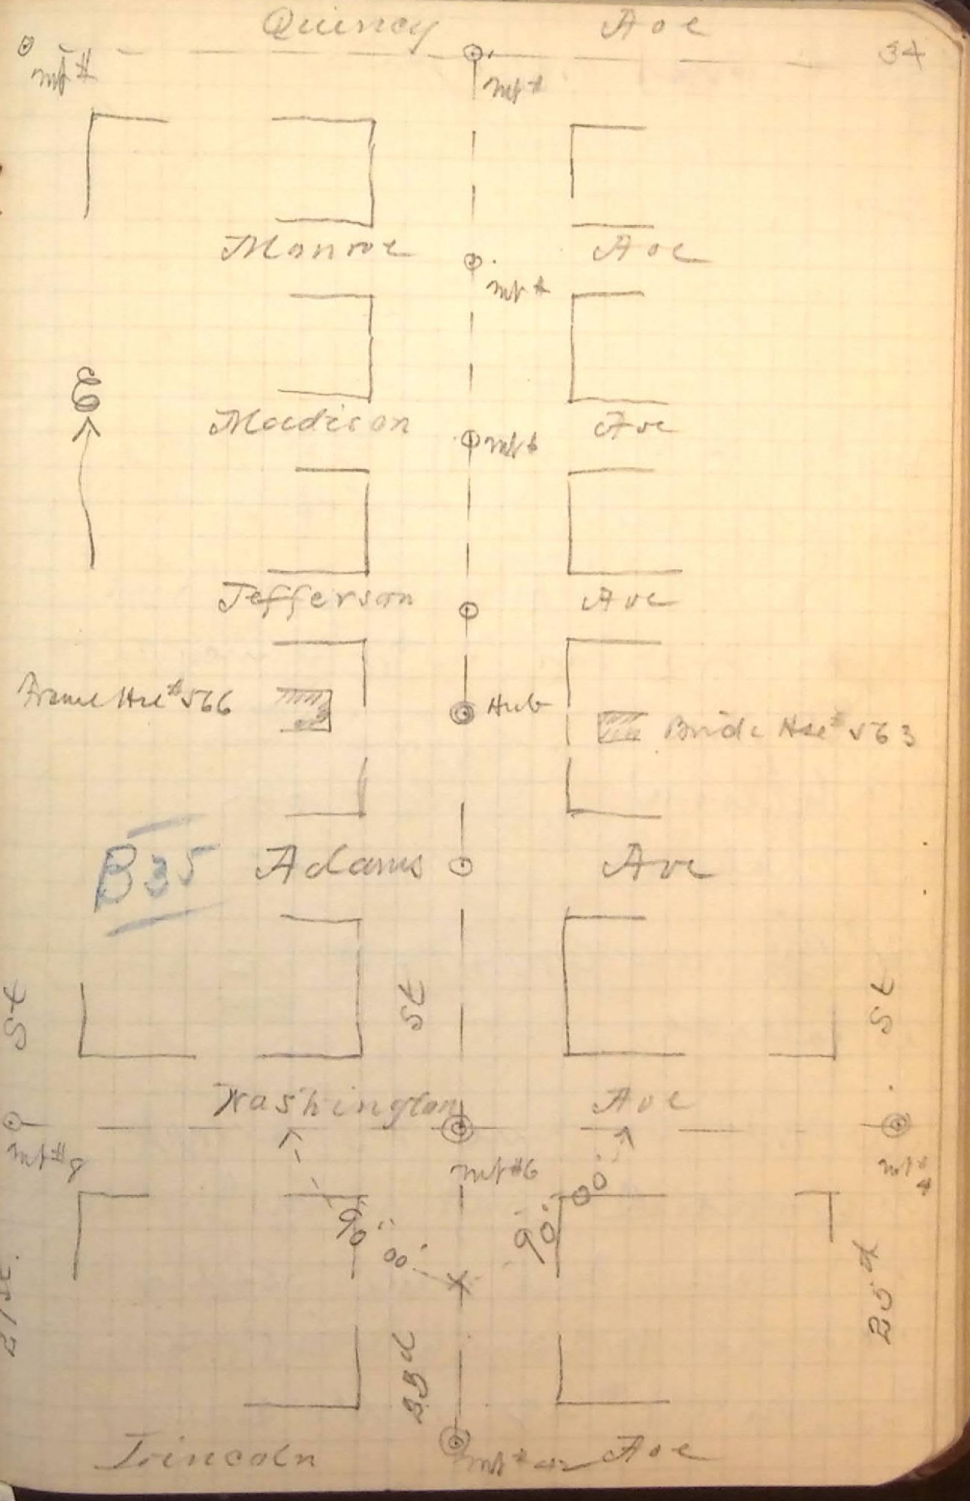
on to Mkr #12 23d & Lincoln as follows
B.S. Mkr #4 (25th & Wash) Angle R & Mkr
Inst over Mkr #6 (Washington & 23d)
checking 23d Street line of Mkrs
Tuesday Am. June 3d, 1890