


68 443° 30' 625° 57'
 67 194 063° 00' N83° 06' E N65 1/2° E
 66 68400 55° 00' S33° 54' E S51° 14' E
 S88° 54' E N74° 48' E

Tuesday Aug, June 10th 1890
 380° 50' 470° 58'

65 0
 64
 63
 62
 61
 60 67° 00' S88° 54' E N74° 48' E
 59
 58 055° 00' N74° 06' E N74° 48' E
 57
 56 060° 00' N77° 06' E N66° E
 55
 54
 53+22 070° 00' S42° 54' E S60° E
 S16° 48' E S34° E
 241° 30' 403° 52'

470° 58' N 0° 58' E
 380° 50' S 88° 54' E
 90° 08' = 90° 08' = check

Sun Dam

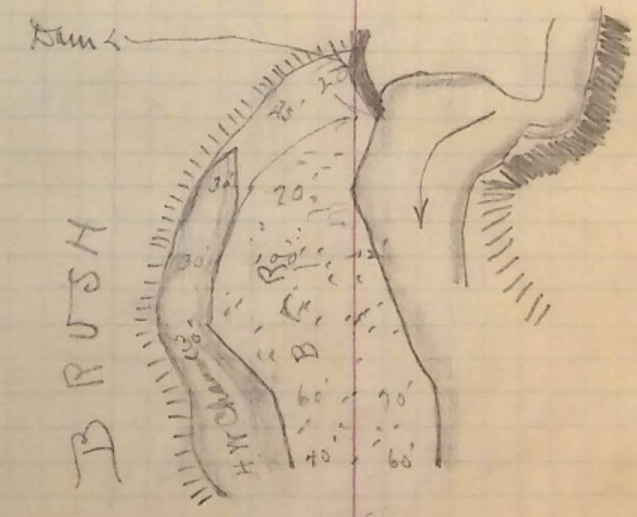

THICK

N.S. produced 150 to 200

BAR

