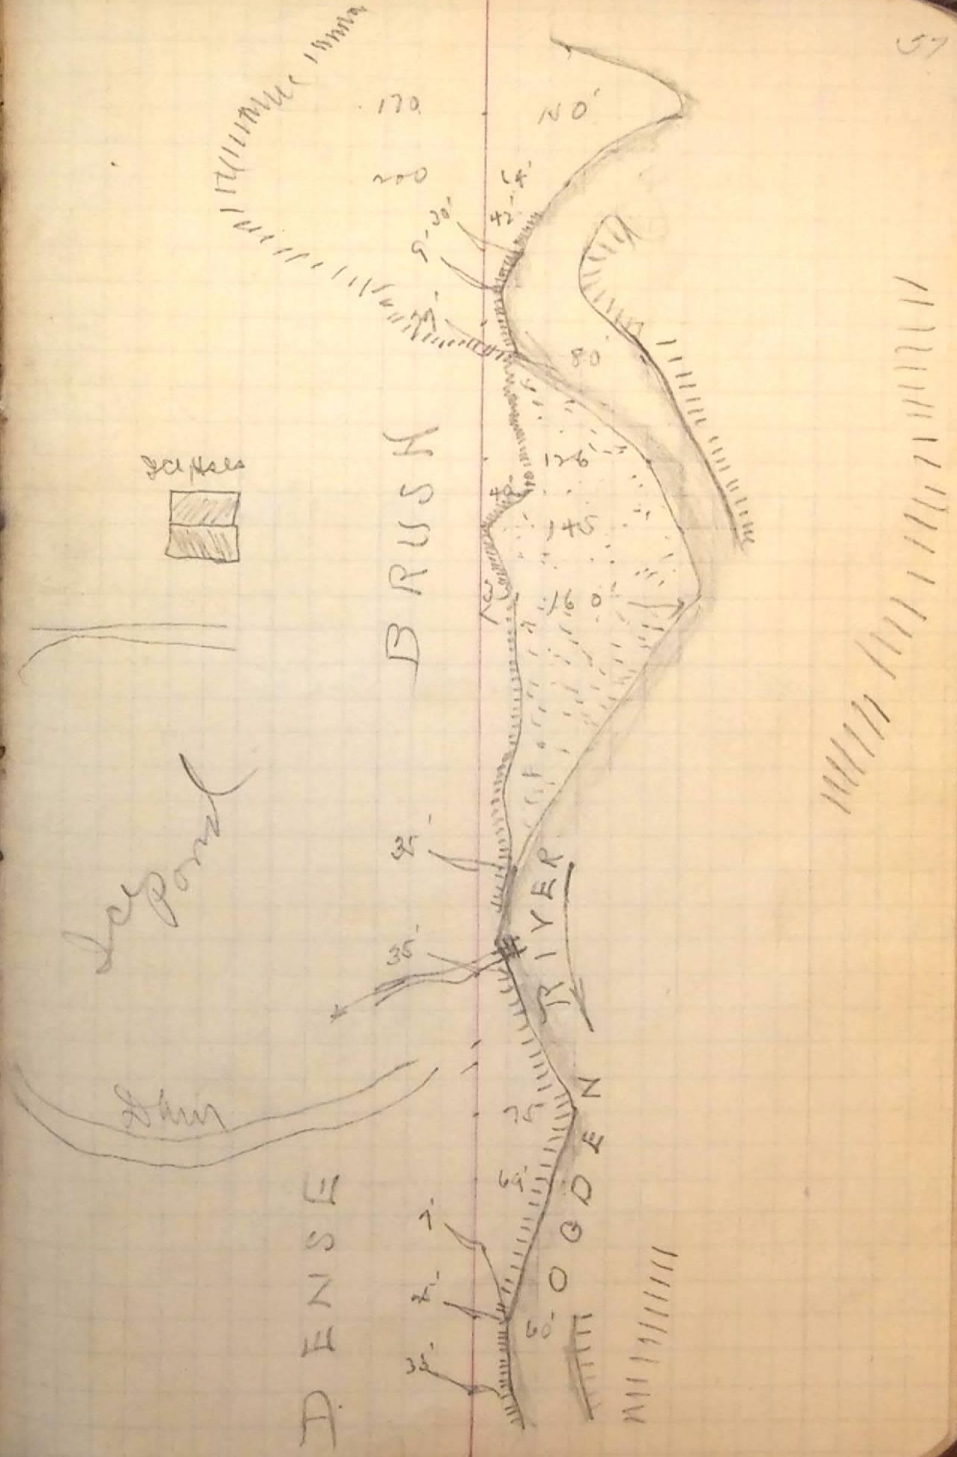87					
86					
85 +24 84	⊙25° 15'		N75° 29' E	N58 1/4 E	
83 +44 82	⊙	12° 30'	S79° 16' E	N83 1/2 E	
81					
80 +25 79	⊙	59° 00'	N88° 14' E	N71° E	B.M.
78 +58 77	⊙	18° 30'	N29° 14' E	N11° E	
76					
+97	⊙25° 09'		N10° 44' E	N6° W	
+252 75	⊙	12° 50'	N35° 53' E	N18 3/4 E	
74 +45 73	⊙6° 53'		N23° 03' E	N6° E	
72 +07 71	⊙53° 10'		N29° 56' E	N13° E	
70					
69					
	443 50	635 58	N83° 06' E	N65 1/2 E