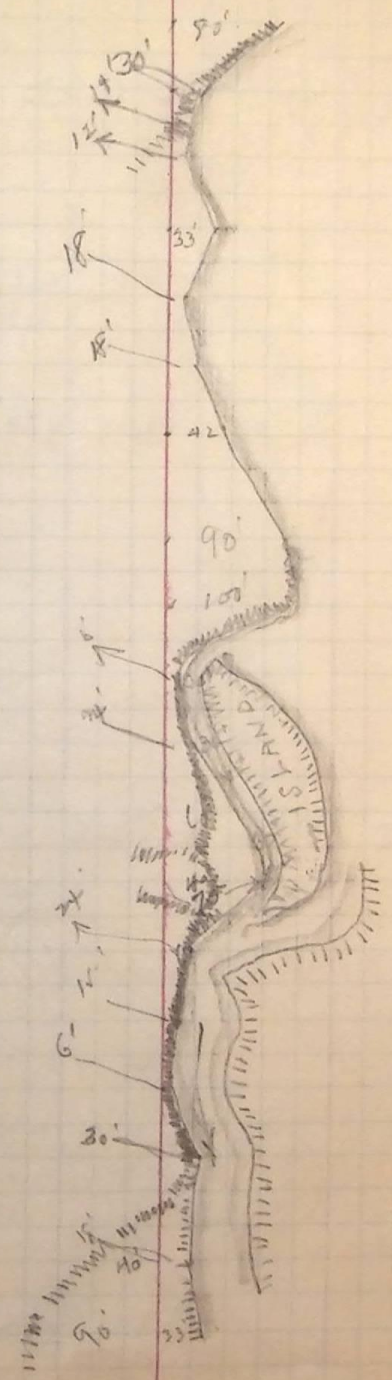106 +79	⊙	59° 54'	N 76° 00' E	N 59 1/4 E
105 +50	⊙ 20° 30'		N 16° 06' E	N 0° E
104				
103				
102 ✓				
101				
100 +79	⊙ 24° 18'		N 36° 36' E	N 20 3/4 E
99				
98 +26	⊙ 48° 00'		N 60° 54' E	N 44° E
97				
96				
95				
94				
93 +35	⊙	25° 55'	S 71° 06' E	S 88° E
92 ✓				
91				
90 +93	⊙	7° 30'	N 82° 59' E	N 65 3/4 E
89				
88				
			N 75° 29' E	N 58 1/4 E