

17
16
15
14
13
12
11
10
9
8
7
6
5
4
3
2
1

12
+23
11 06° 00'

S61° 02' N S45 1/4 W

6
+15 02° 00'



S67° 02' N S51 1/2 W

2485'
2782'
+92
+76
1

S87° 02' N

Wesley Advance mill race Wash & Mallow
Monday AM. June 20 1890

mill race
= Board fence East Onp line Great

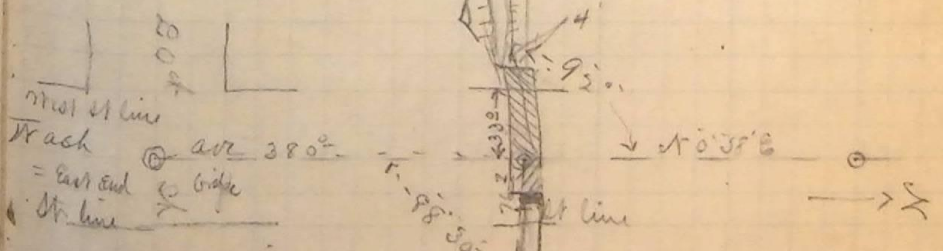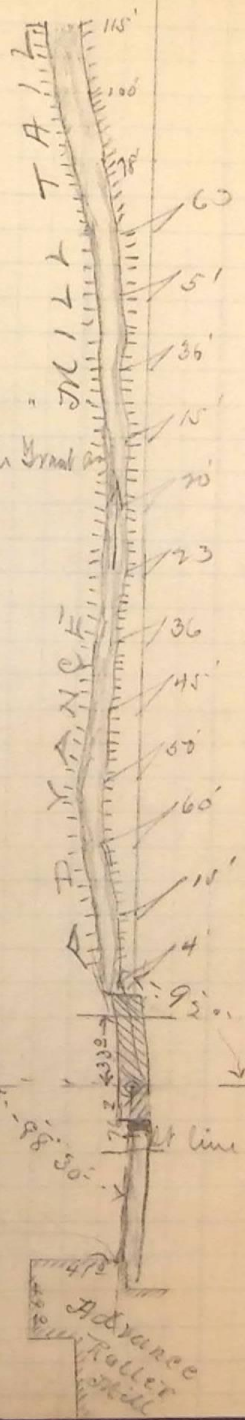

Wash on mill