

24

23

+48

22

21

+83 50

31° 00' S 19° 02' W = 42' 41"

20


19

+82 00 55 00

S 18° 02' W S 13° W

18

S 61° 02' W S 48° 41"

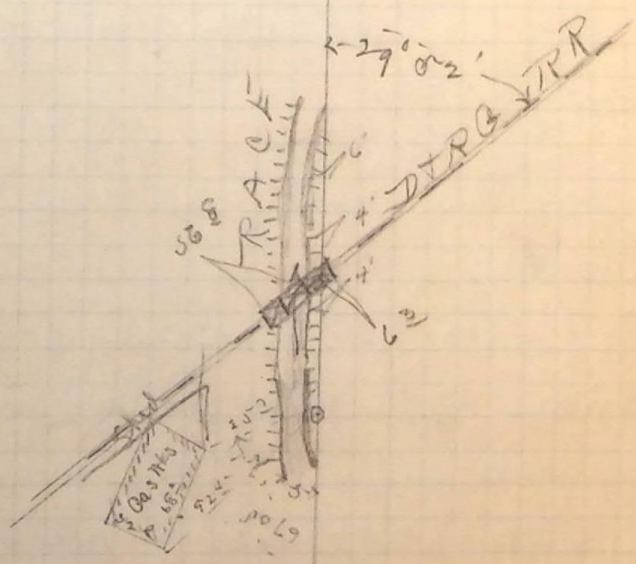

11 114