


26th and Jefferson

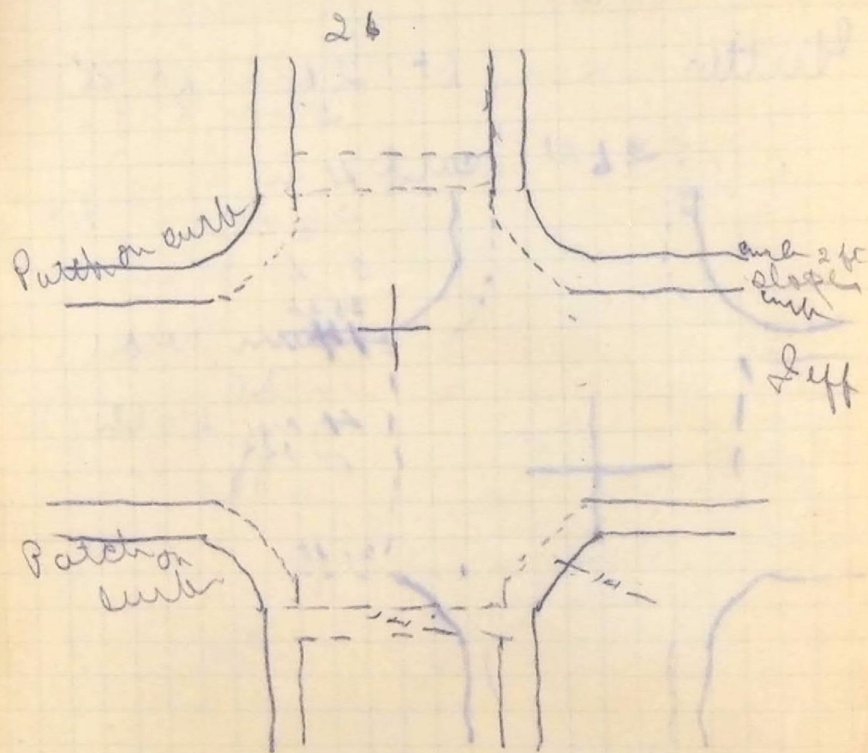

25th and Mad

