South Abutment Ogden River Bridge
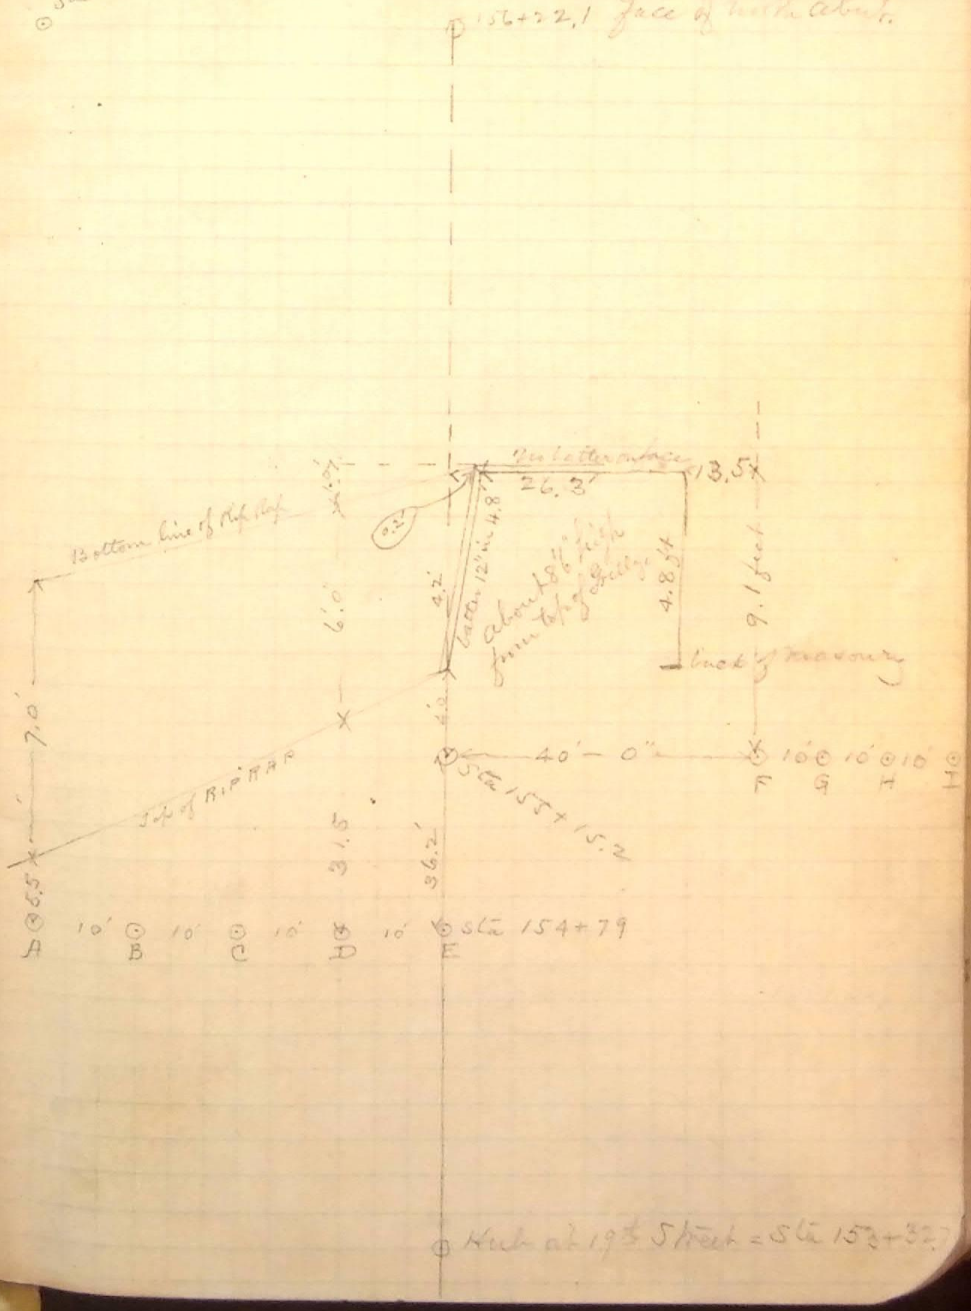
July 11th 1890. Notes by Horton