Meander Advance Mill Race
Southwest from Washington Avenue.
July 15-90

17 + 71 23°53' R. deflection
17
16
15
14 ⊙ 42°35' R. deflection
13
+65.5 29°15' Left deflection
12
11
10
9
8 +33.5 17°00' Left deflection.
7
6
5
4
3
2 +62.5 19°13' L. deflection.
1
0 87°45' R angle from B.S. on Mon at 21st Street

Meander Advance Mill Race.
From Washington Ave. Southwest.
July 15-90

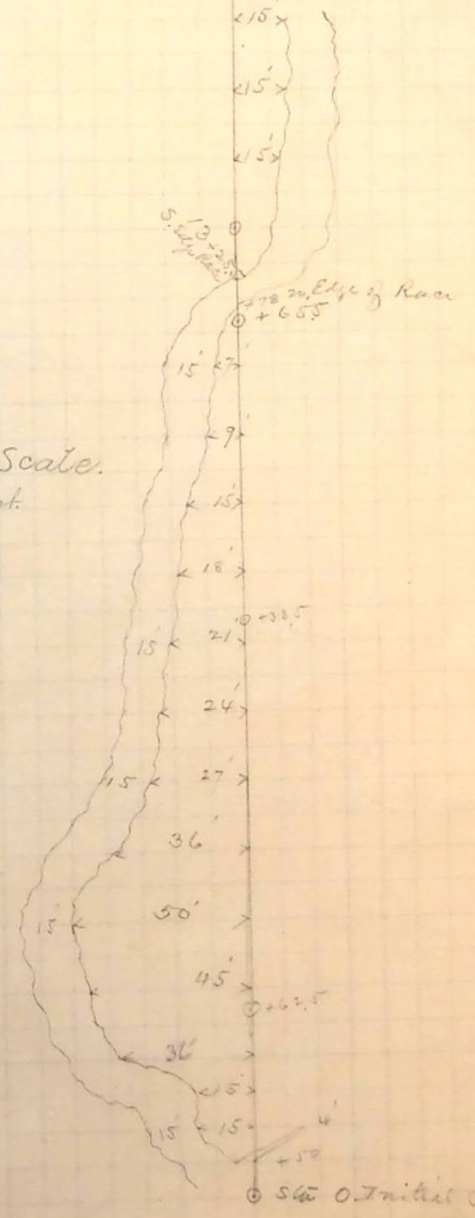

HORIZONTAL Scale.
1 Square = 10 feet.

Initial Point 37 ft South of Center 19th St. and
10 ft West of Center of Washington Ave.