Meander of Advance Mill Race N.E. from Washington Ave.

10

9+39 ⊙ 20°30' IIR deflection

9

8

7+22.5 ⊙ 18°30' IIa deflection

7

6.

5+73 ⊙ 57°-16' IIR deflection

5

4 +68 ⊙ 53°38' IIa deflection

July 16-90

3

2 +83 ⊙ 12°00' IIa deflection

1

0 Sta ⊙ A.C. 97°30' from B.S. on Mon 21st & Penn ave.

July 15-90
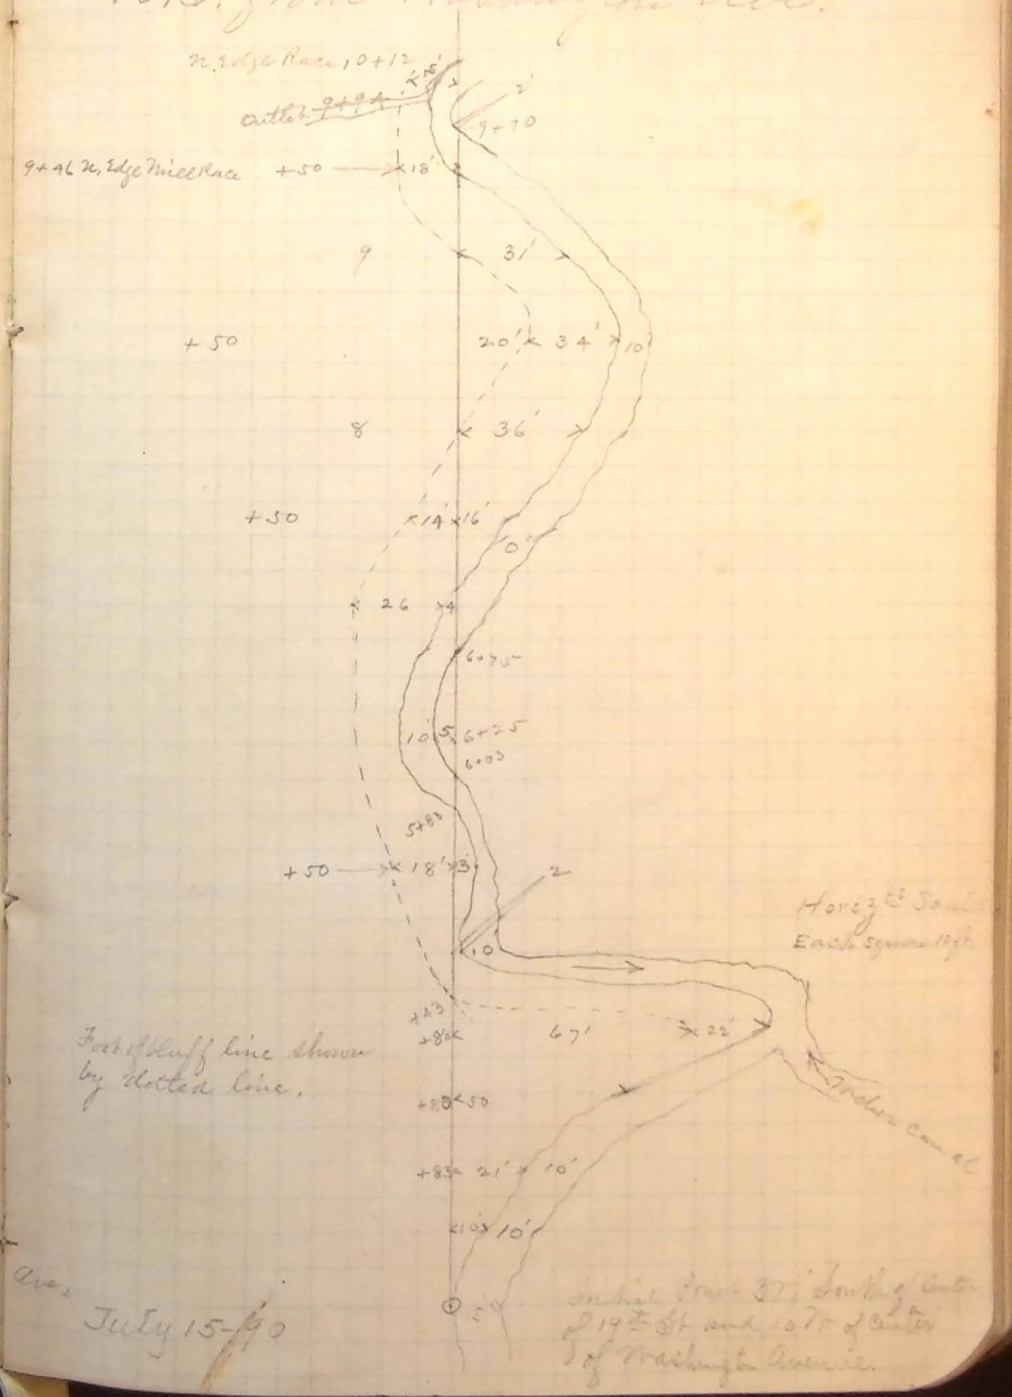
Meander of Advance Mill Race N.E. from Washington Ave.