Meander Advance Mills Race

+47.5 ⊙

22

21

20 +27.50 ⊙ 3°30′ IIa. deflection

19 +3.4 ⊙ 3°00 R deflection

+28 ⊙ 5°00 IIa. deflection

18

17

16 15+76 ⊙ 2°00 IIa deflection

15

14 13+89 ⊙ 14°55 IIa deflection

13 12+85 ⊙ 55°00 R. deflection

12

11 10+81 ⊙ 64°00 IIa. deflection

10

N.E from Washington Ave

6

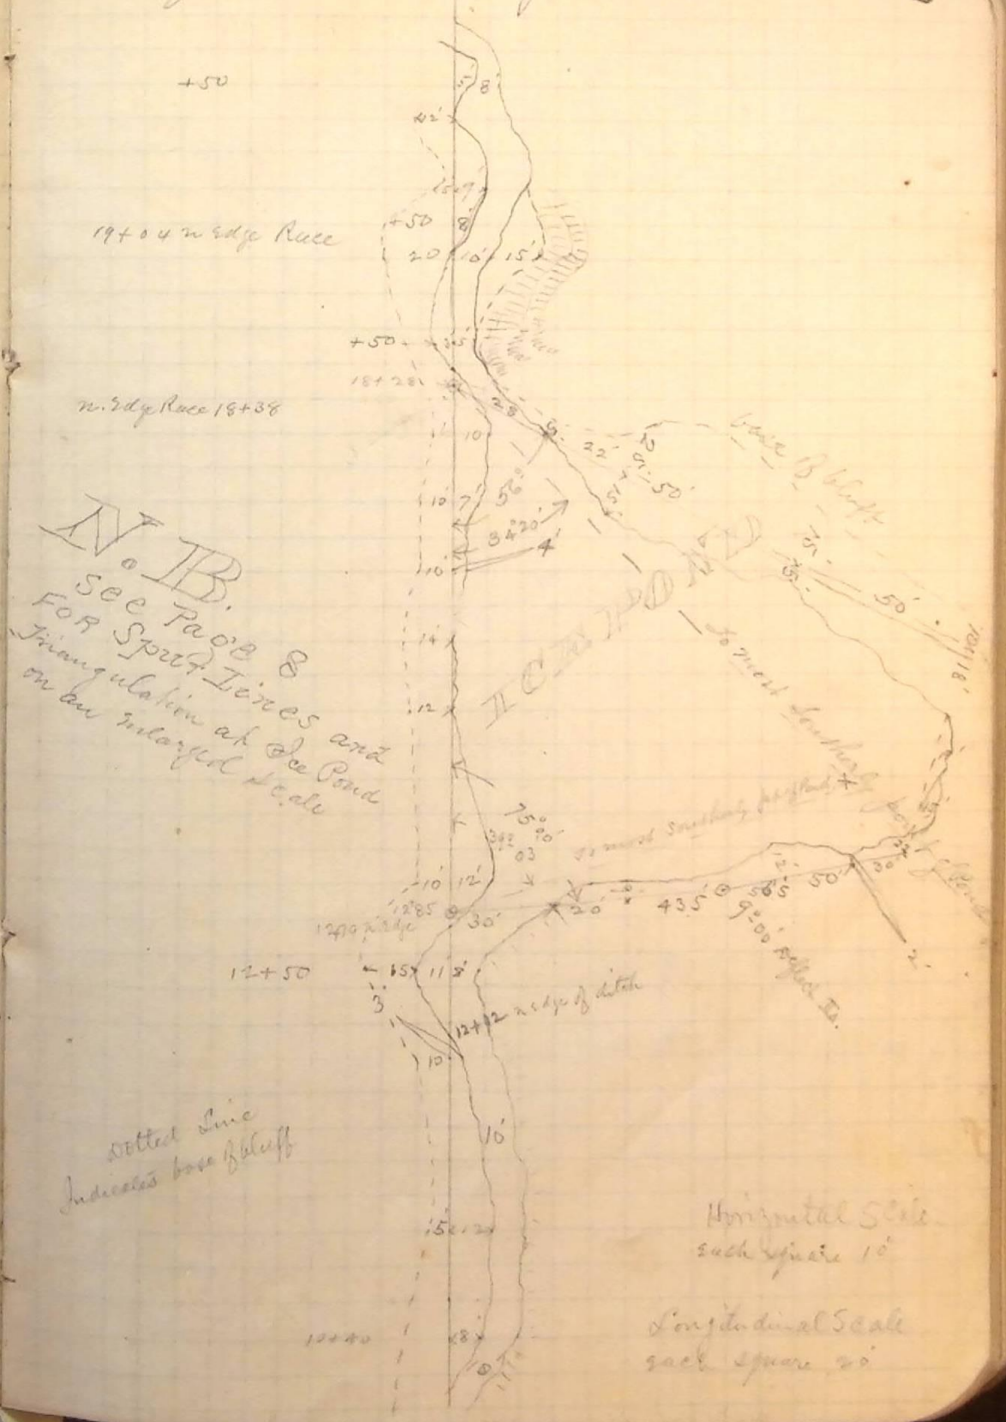
+50
19+04 n edge Race
+50
18+28
n. edge Race 18+38
N° IB.
See Page 8
FOR Spirit Lines and
Triangulation at the Pond
on an enlarged Scale
Edge of bluff
50
50
50