



8A. Meander of 28th St ditch.
From 28th St & Pacific Avenue
to junction of Weber River

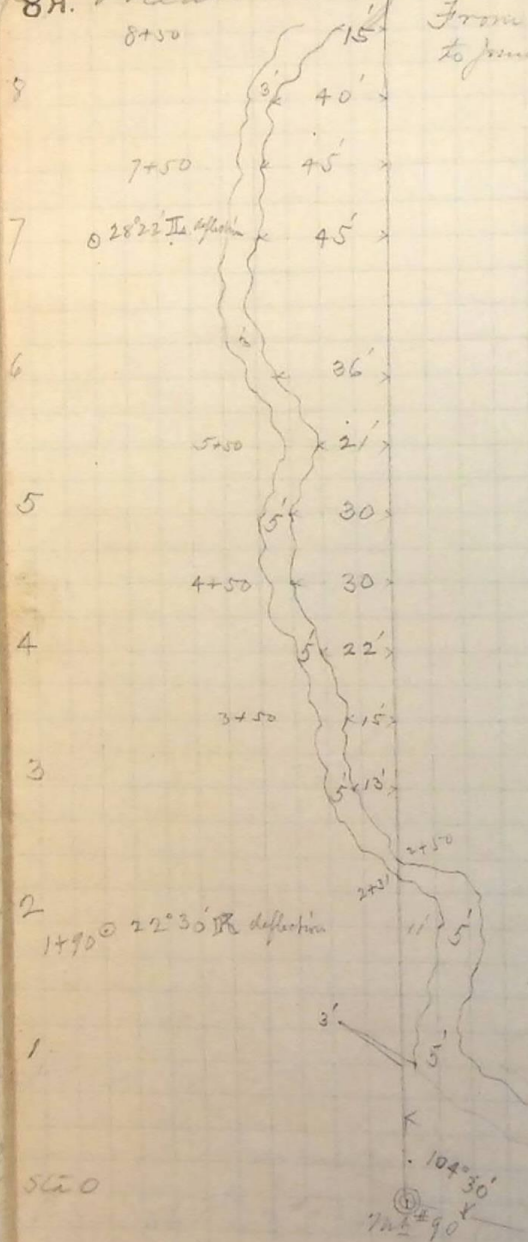

Meander of 28th St ditch.

July 17 - 90
WALL @ Pacific Avenue

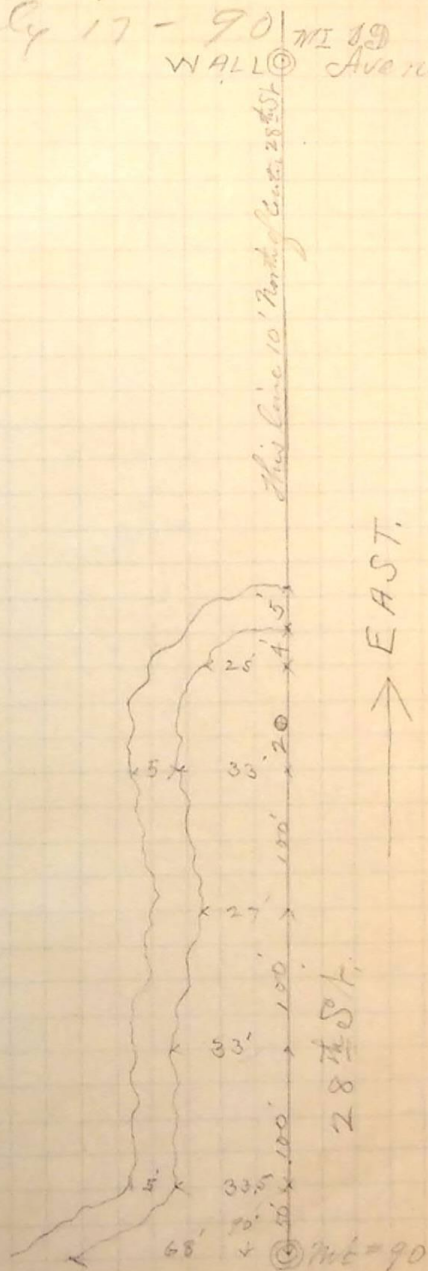

9