


Meander of 28th St ditch from Mt^o 90 to
 Continued on oppo-
 site page (Page 10)

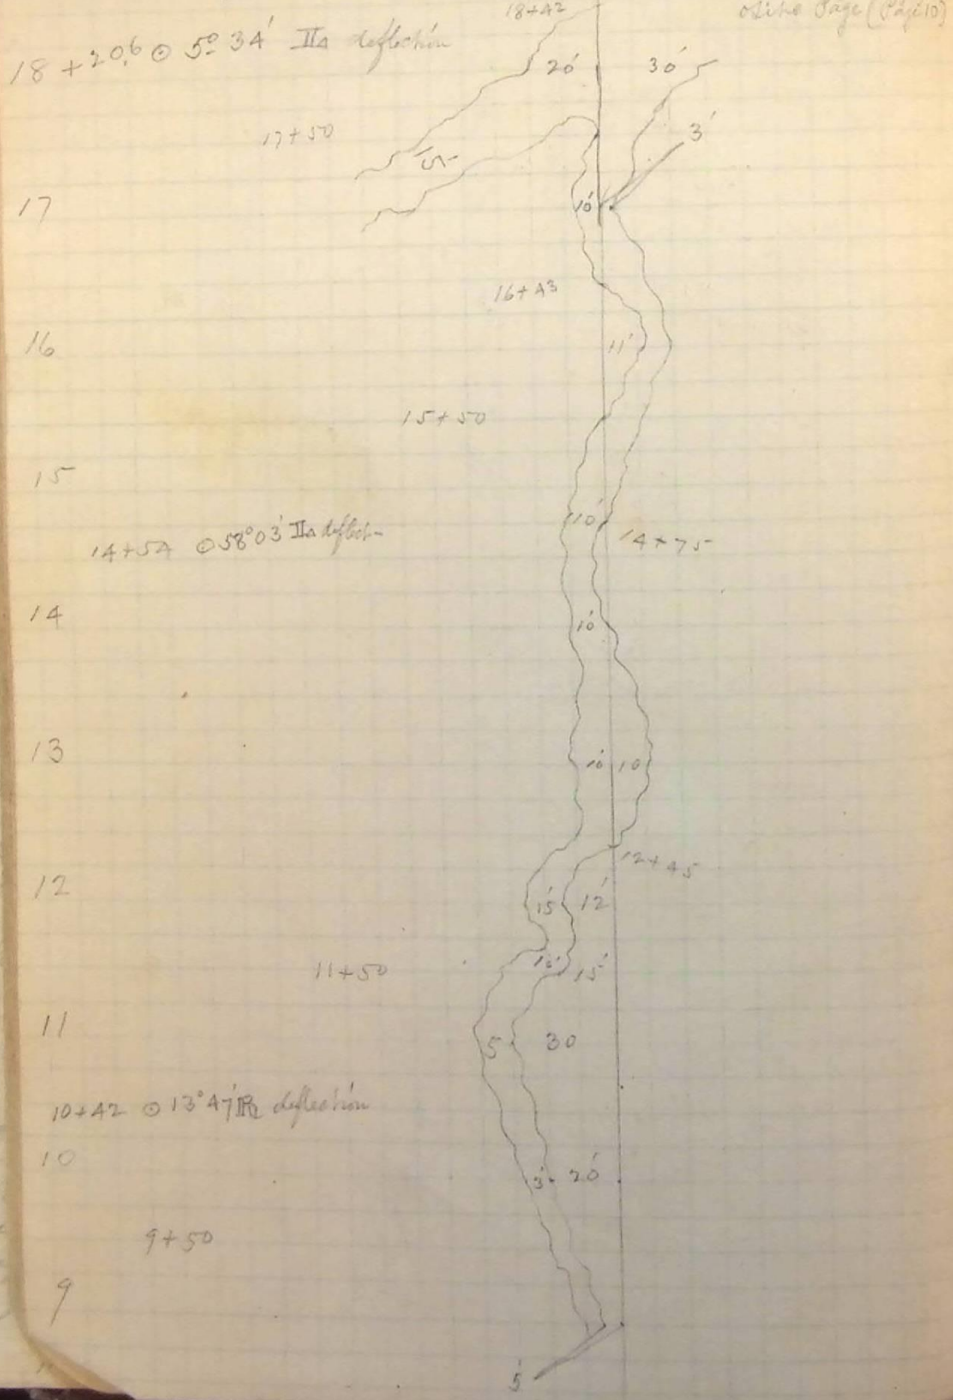

Riber River

July 17th 1890. 10

