


Center and Curb Stakes for Grading.

On 26th St from Lincoln to Hall.

Set these stakes Monday A.M. July 21-90

Location of East Point to R.R. P. 1A
Bridges over Miller River, with reference to
Outlet of sewer on 21st St.

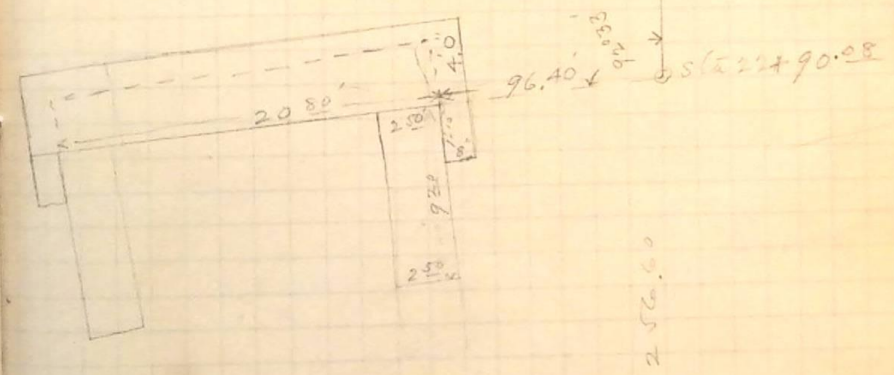

Sta 25+46.68

Sta 22+29.58