


Meander of Weber Canal from
24th St North -

P. Mc Aug 8-90

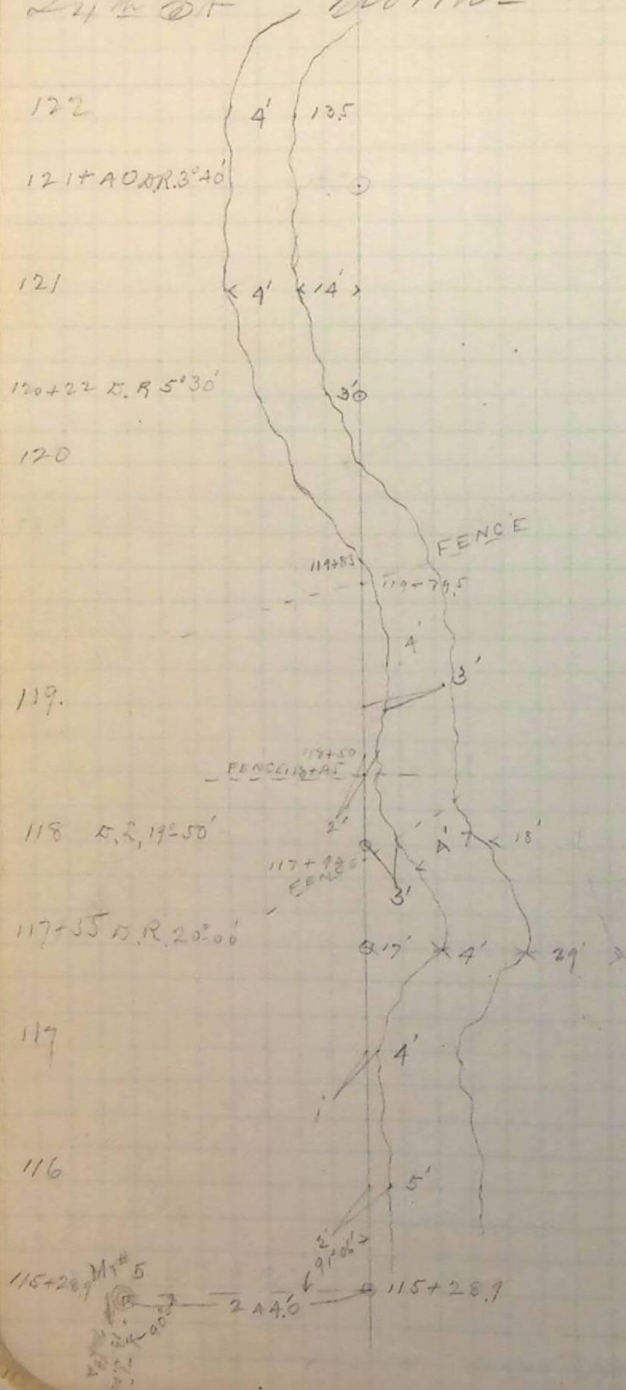

Meander, Weber Canal from
24th St North -

27

P. Mc Aug 8-90

