


Meander of Miller Canal from
24th St to Advance Mill Race

P.M. Aug 9th 1890

151-78.2 = 4+68 OF Advance Roller Mill Ditch Meander
D.S. 1222 to 562 5+73 Advance Mill Race Meander

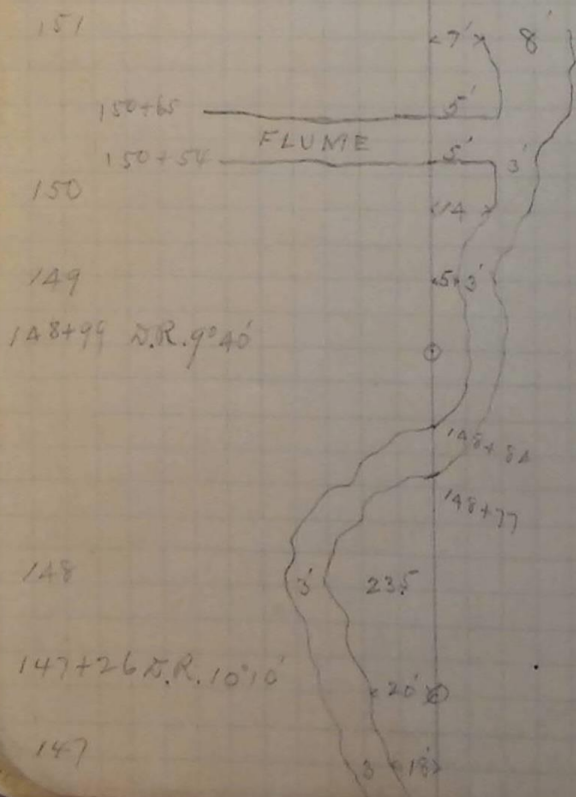

Center Point for Cross-Section on
Lincoln Ave from 28th St to 30th St. 29

54+71.85 = Center 78.54

84

83

82

81

80

79

78

77

76

75

74

73

72

71

70

70

Center 30th St = 64+53.85

A.M.
Aug 12-90

