

Rail Centers for Cross Section

Notes Lincoln Ave. 30<sup>th</sup> to 31<sup>st</sup> Sts

J. M.



Aug 12<sup>th</sup> 1890

69+54

67+70

67


66

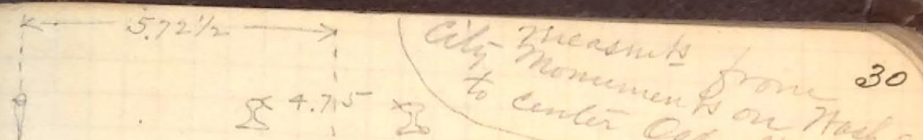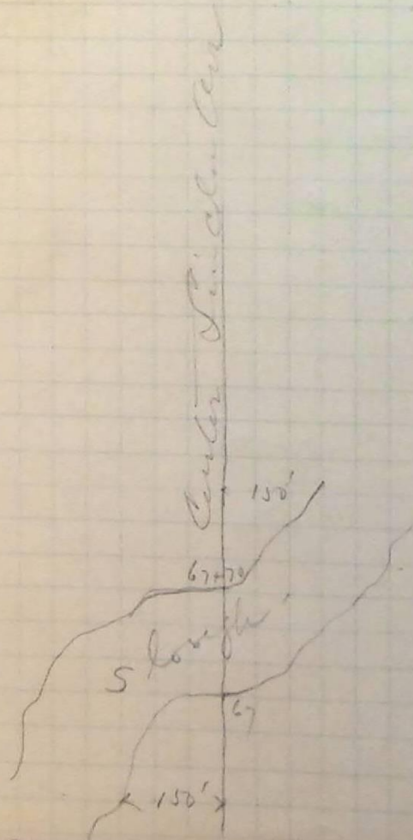

City measurements from 30<sup>th</sup> Monument on Wash. Ave. to center of Lincoln Ave. track


19<sup>th</sup> St & Washington Ave Sta NS+152

is 7.64 ft west of center C.C. Ry track

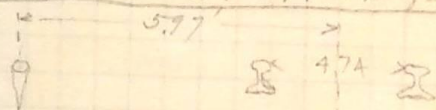


Rail head 2.14 miles

20<sup>th</sup> St and Wash Ave

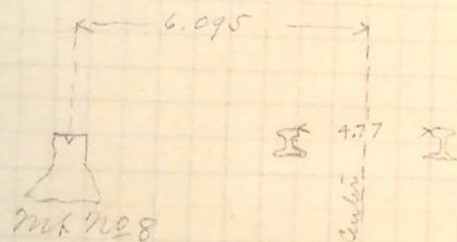


J. M. Aug 12 to 21<sup>st</sup> & Washington

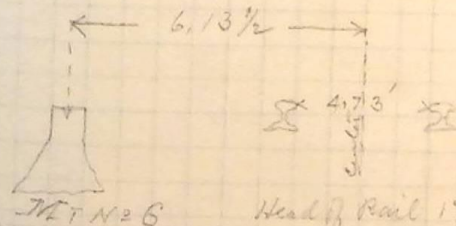


Head of Rail 1 7/8 miles

23<sup>rd</sup> & Washington

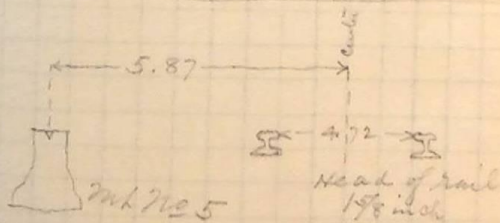


24<sup>th</sup> and Washington

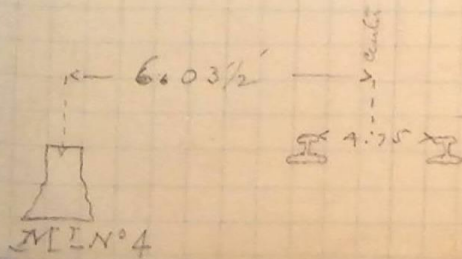

25<sup>th</sup> & Washington