



Centers for x Section Notes on Hall Ave
from 32nd to Pincocks Lane.

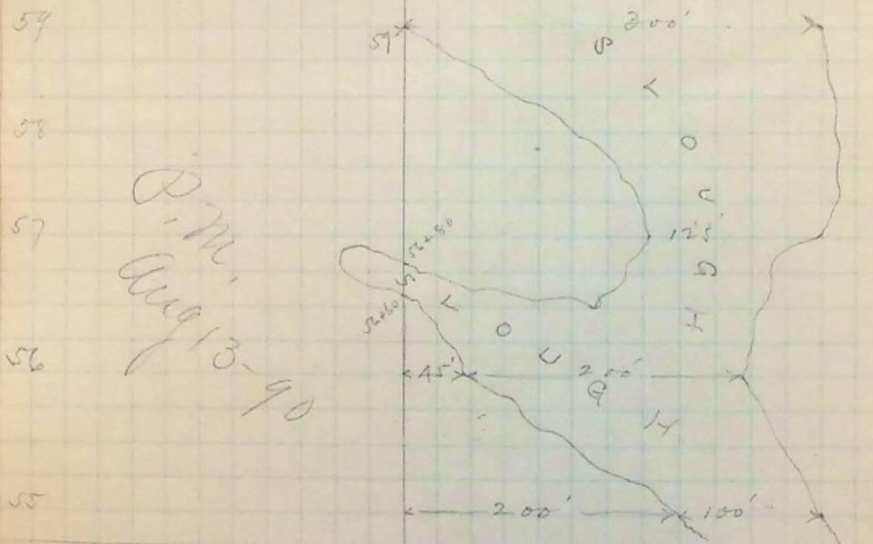

P.M. Aug 13-90

← 250' to station 51+50

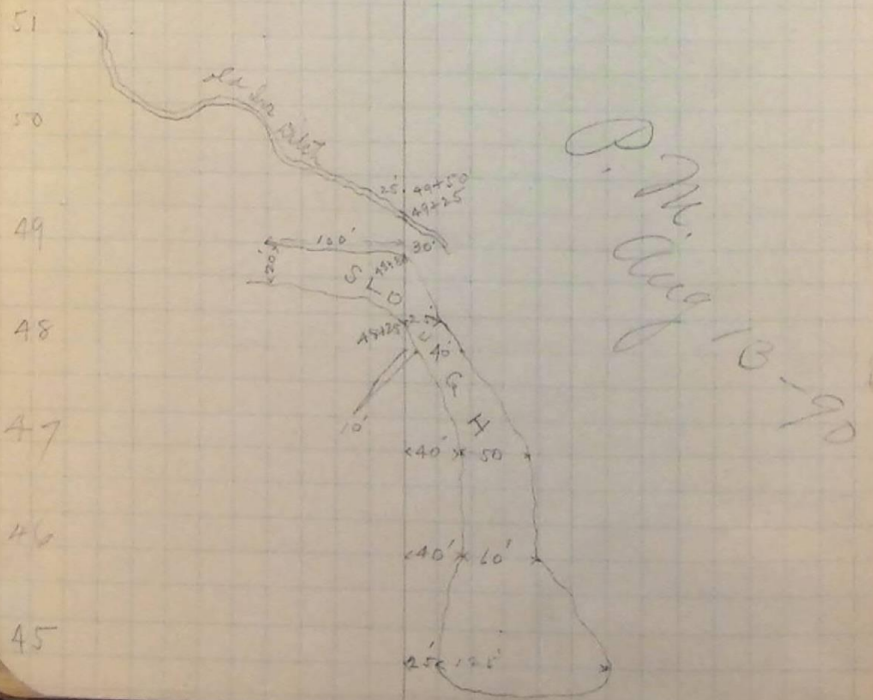

P.M. Aug 13-90

Centers for x Section Notes on
31st St. Hall Ave to Lincoln Ave.

P.M. Aug 13th 1890

