
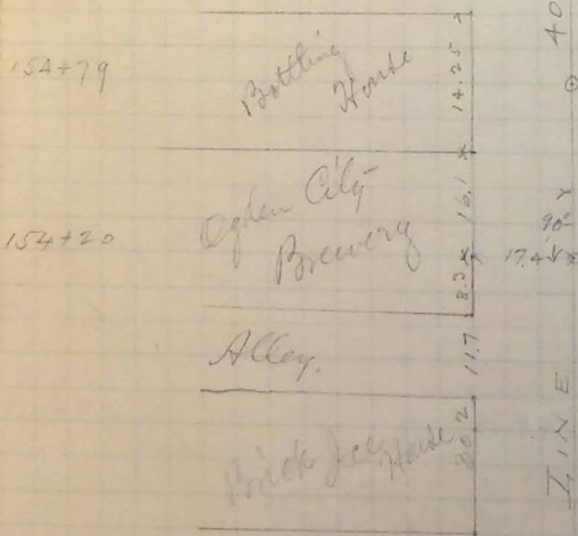


Measurements to adjacent to Bridge Site

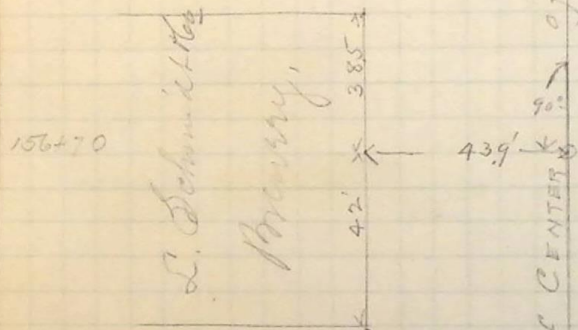

40' W. of CENTER of Washington

Locate building Ogden River + Washington

A.M. Aug 15th 90

40'

40'

Centers for Section on 31st St. 33 to Sta 126 being 300ft E of Center Median Ave

123

122+75

120+65

115+05


100 at Washington Avenue.

Centers for Section Notes 31st St from Lincoln to Washington Ave  
A.M. Aug 16th 1890

92

91

90

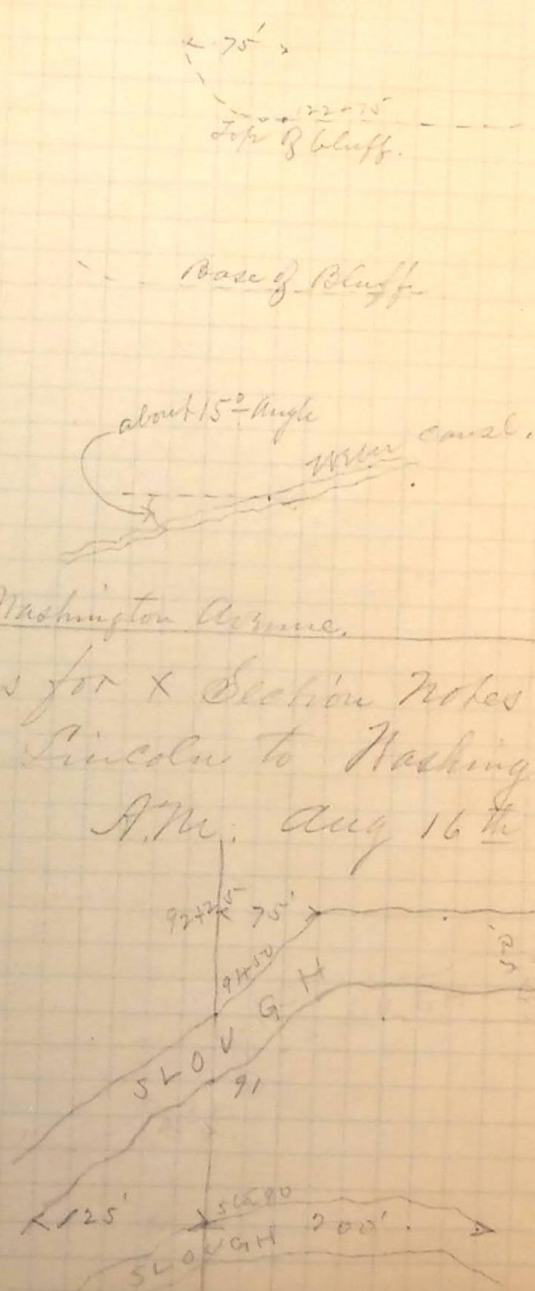

P.M. Aug 16-90