


Meander N<sup>th</sup> St  
Swan,

Continued P. 40

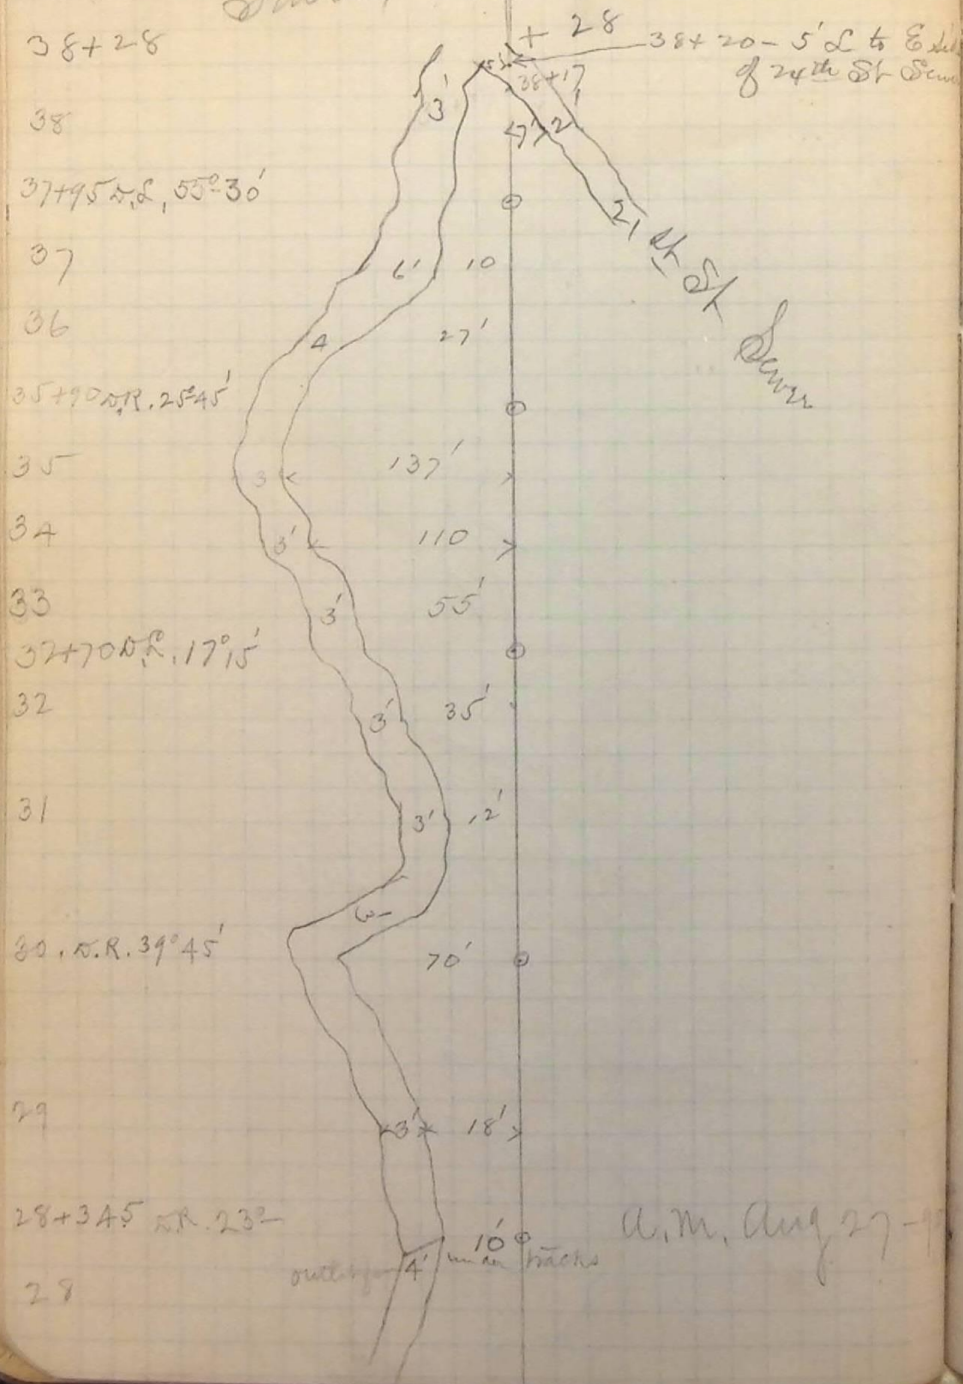

Set stakes every 10 feet for  
cross-walks on N<sup>th</sup> & S sides of  
24<sup>th</sup> St and crossing Jefferson Ave.

Also on N<sup>th</sup> & S sides of 20<sup>th</sup> St  
and crossing Jefferson Avenue.

A. M., Aug 20<sup>th</sup> 1890

A. M., Aug 27-90