



Se Abut. Track - Ave + Cyclan River.

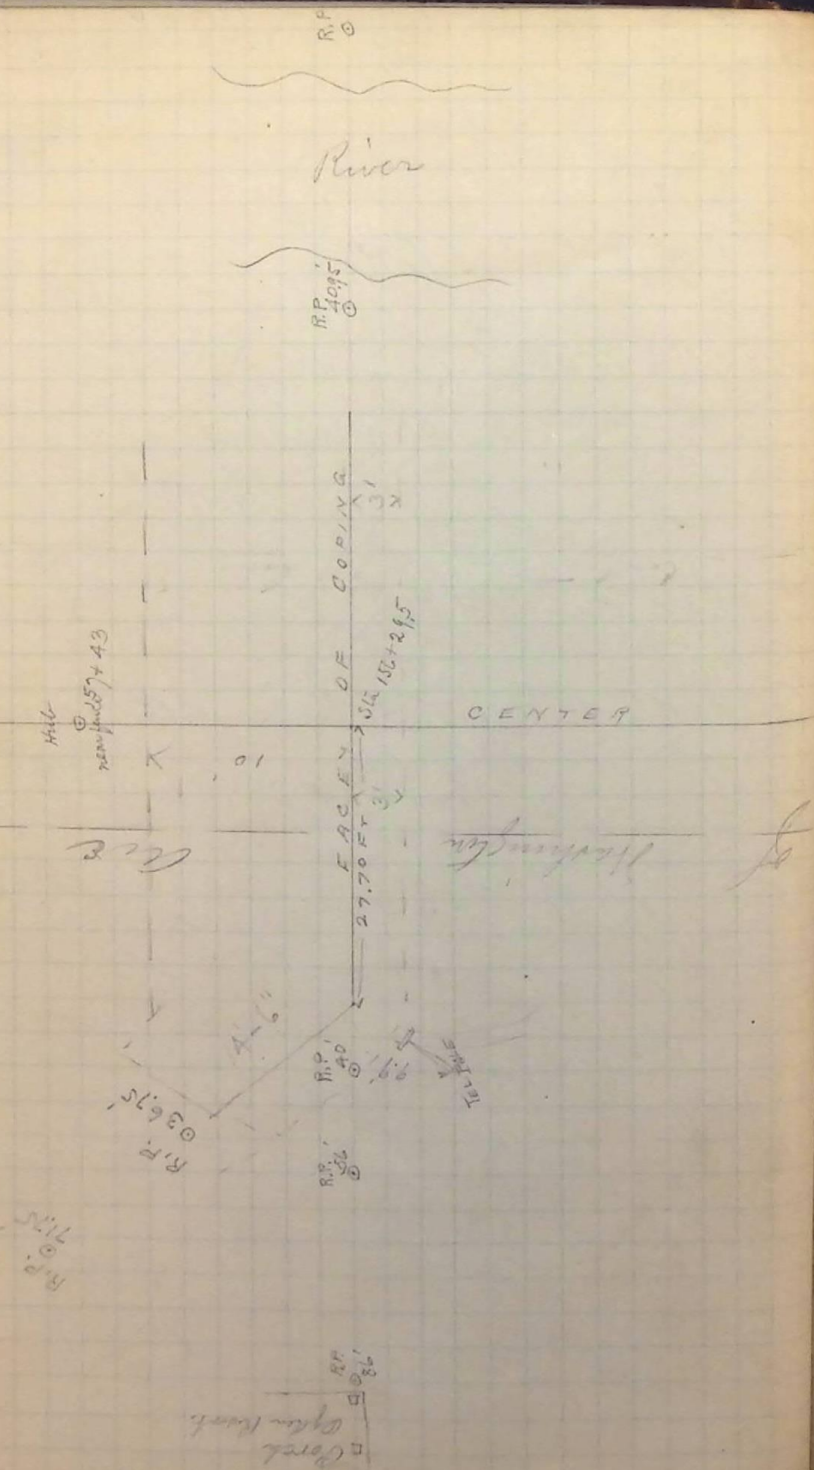

So. Abutment.

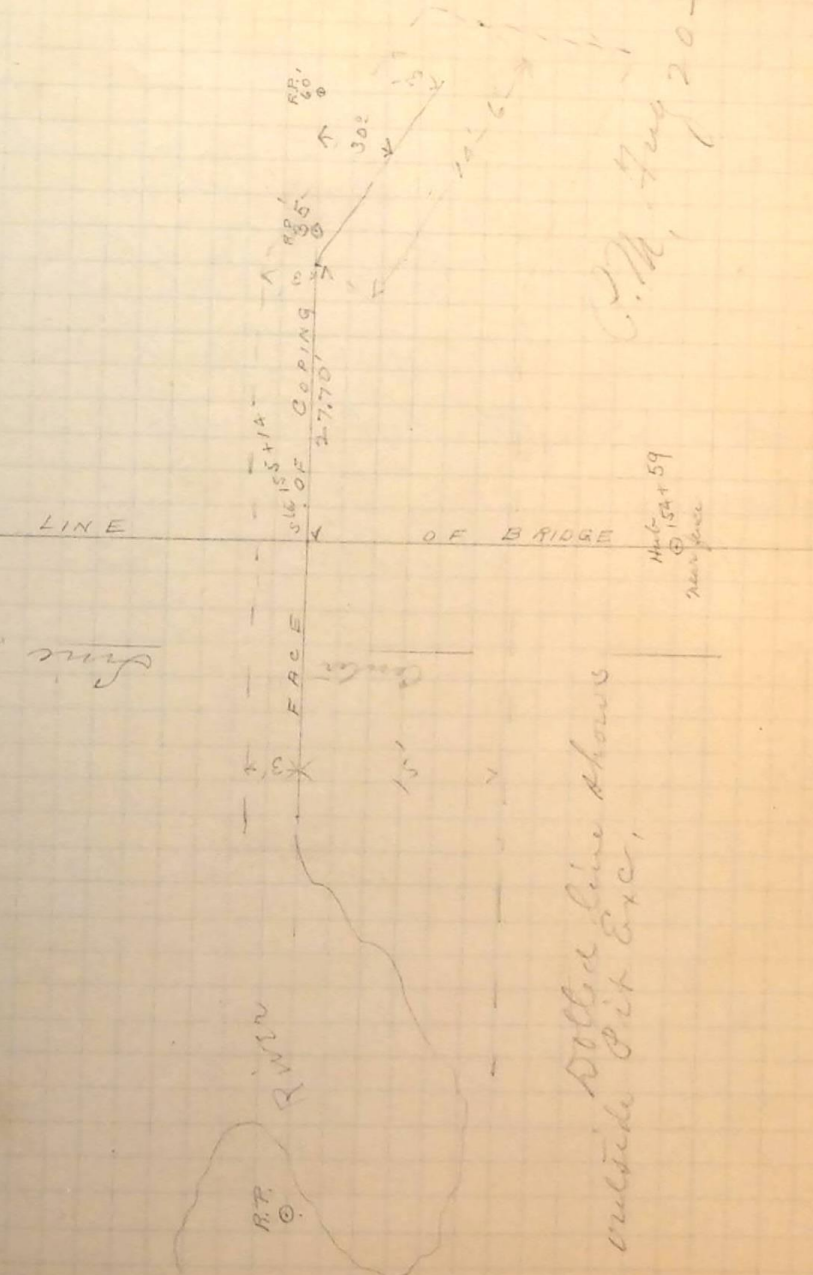

C.M. Aug 20-90