

Set stakes for Electric Light Poles 1020 ft N and 5 ft E of Mt at 22nd + Hall; also at 26th and Grant 3 ft S, and E. of Monument.

J. M. Aug 23rd 1890


On acct of being too close to Framing tracks above Pole at 26th + Grant was changed to a point 6 ft S and 3 feet E of monument. (A. R. Shaw)

J. M. Aug 27th 1890

A. M.

48+71
+90
47
+50
46
45
44
43
42
41
40
39

End of Meander of 24th St Sewer

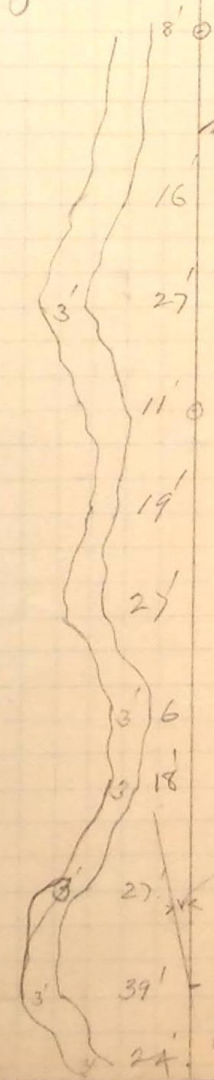

Mudcatcher's House

10.45 = 52.35

10. R. 23° 00'

angle 152° 53' Left
40 + 10.45 = 50.45 of meander
= 50 + 86.55 of sewer
Stakes 7' South of Center