


Set Pins for Cross-Section  
 On Orchard Ave from 25<sup>th</sup> St  
 to 26<sup>th</sup> St.

A.M. Aug 28<sup>th</sup> 1890

Meander Ogden Bench Canal 41  
 From 25<sup>th</sup> & Quincy to 22<sup>nd</sup> St

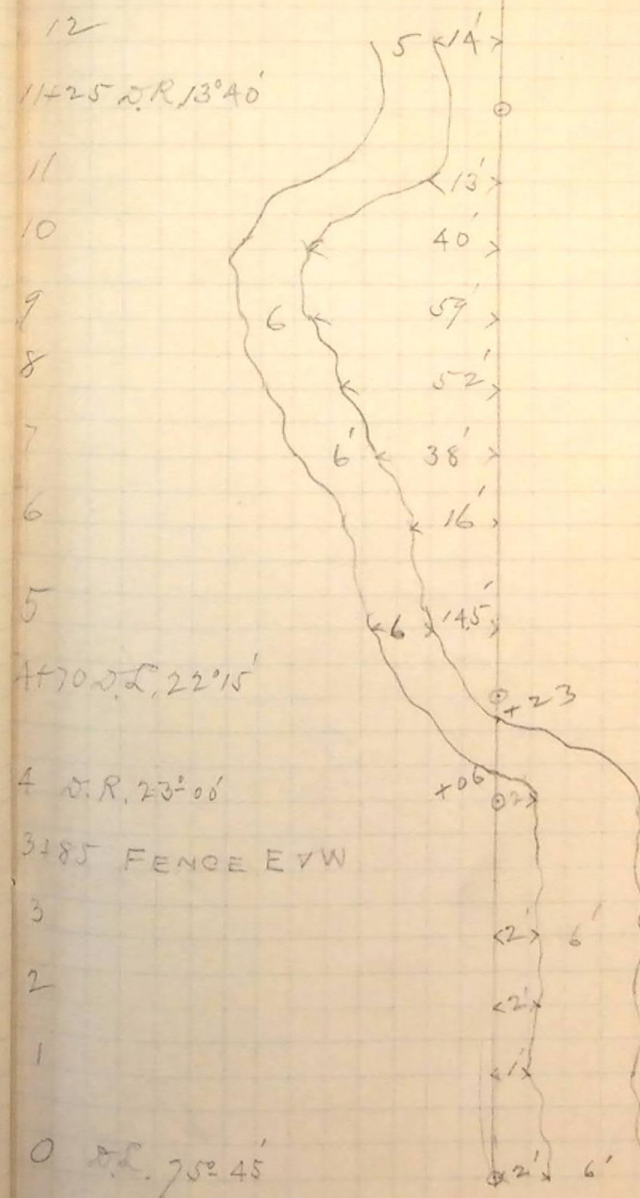

Began Meander Ogden Bench Canal  
 178 feet E of Mt 159 (Cor 25<sup>th</sup> & Quincy on  
 W. S. on Mt 57 from Hub 178 East then  
 reflect to S 75°45'

Sta 0 = 178 ft  
 E of Mt 159