


Meander of Ogden Branch Canal. (Continued)

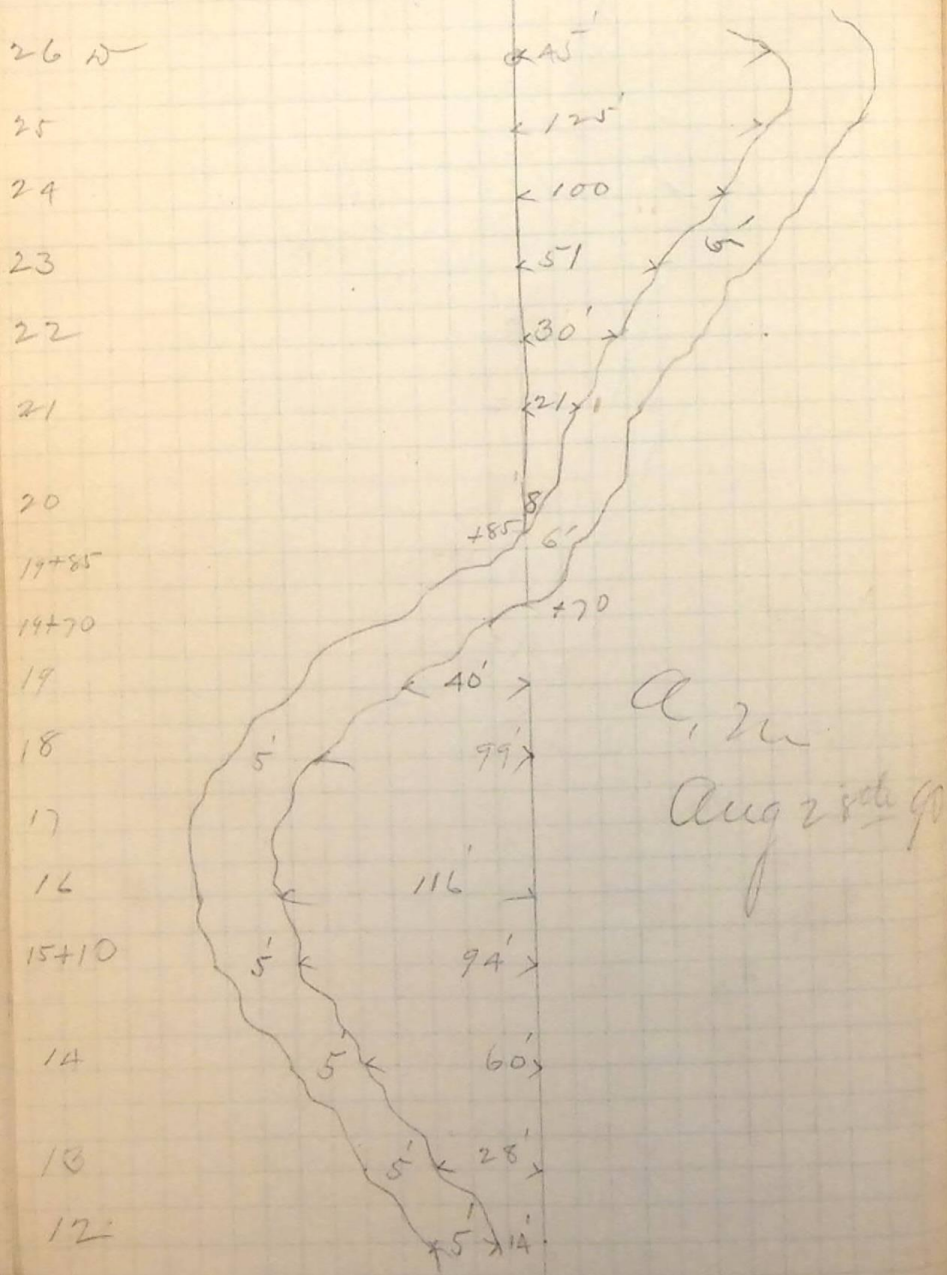

Set Hubs for Cross-Stacks on
 24th St and crossing Lincoln
 Ave. Hubs are 4 ft North and 4
 ft South of center of cross-roads.

P.M. Aug 28th 1890,