


Set Points for Masonry on  
 Timber Platform for No. 10  
 Cyclon River Bridge, as per  
 diagram below

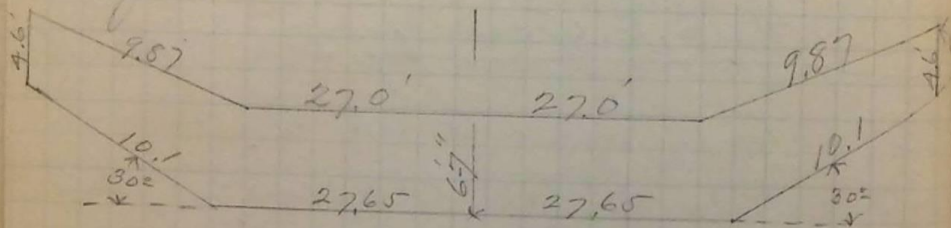

P.M.  
 Sept 27-90

— For Electric Light Company 61  
 Set Stakes on West Curb Line of  
 Grant Ave from 28<sup>th</sup> to 20<sup>th</sup>  
 Streets - putting in 3 cross-  
 section stakes to each block,  
 — also on South Curb line  
 of 23<sup>rd</sup> St (3 stakes to a block)  
 from Lincoln Ave to  
 Madison Ave, these stakes being  
 for Electric Light Company.  
 P.M. Oct 1<sup>st</sup> 90