


Set Stakes and Pins for Curb Grade
on West Curb line of Jefferson Ave
from 25th St to 26th St.


Sta 100+355 to 107+269
25th St @ mk #53

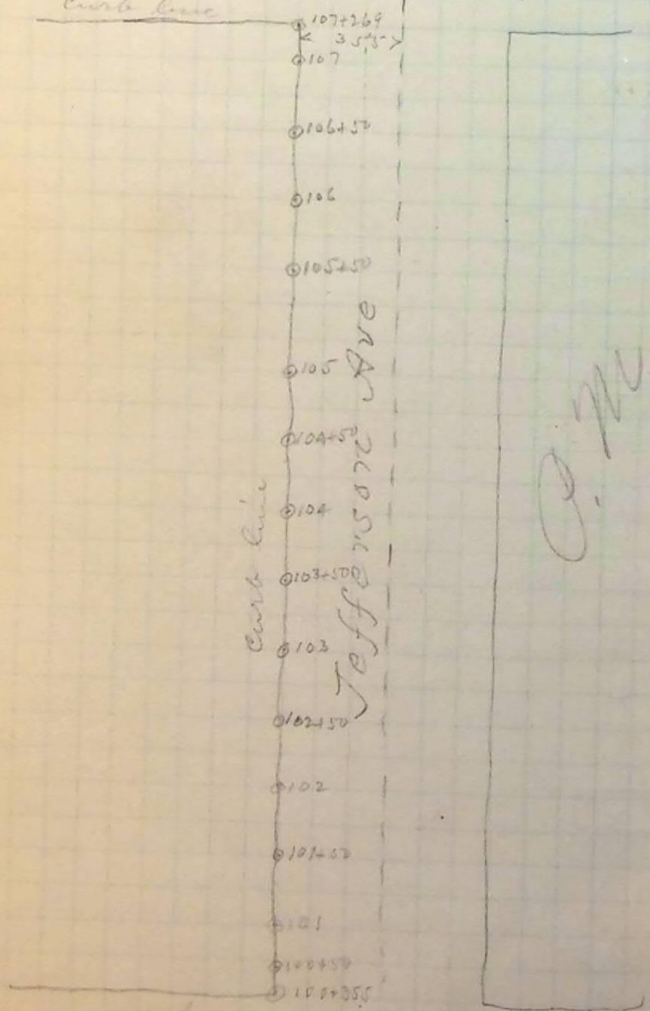

26th St @ mk #46

P. M.
Oct 13th 1890

Set hubs and stakes for Curb Grades on West⁶⁷
Curb Line of Washington Ave. from
26th St to 27th St. (Sta 99+645 to Sta 92+7185)
Also on line 2 ft West of curb on E. Side Wash Ave.

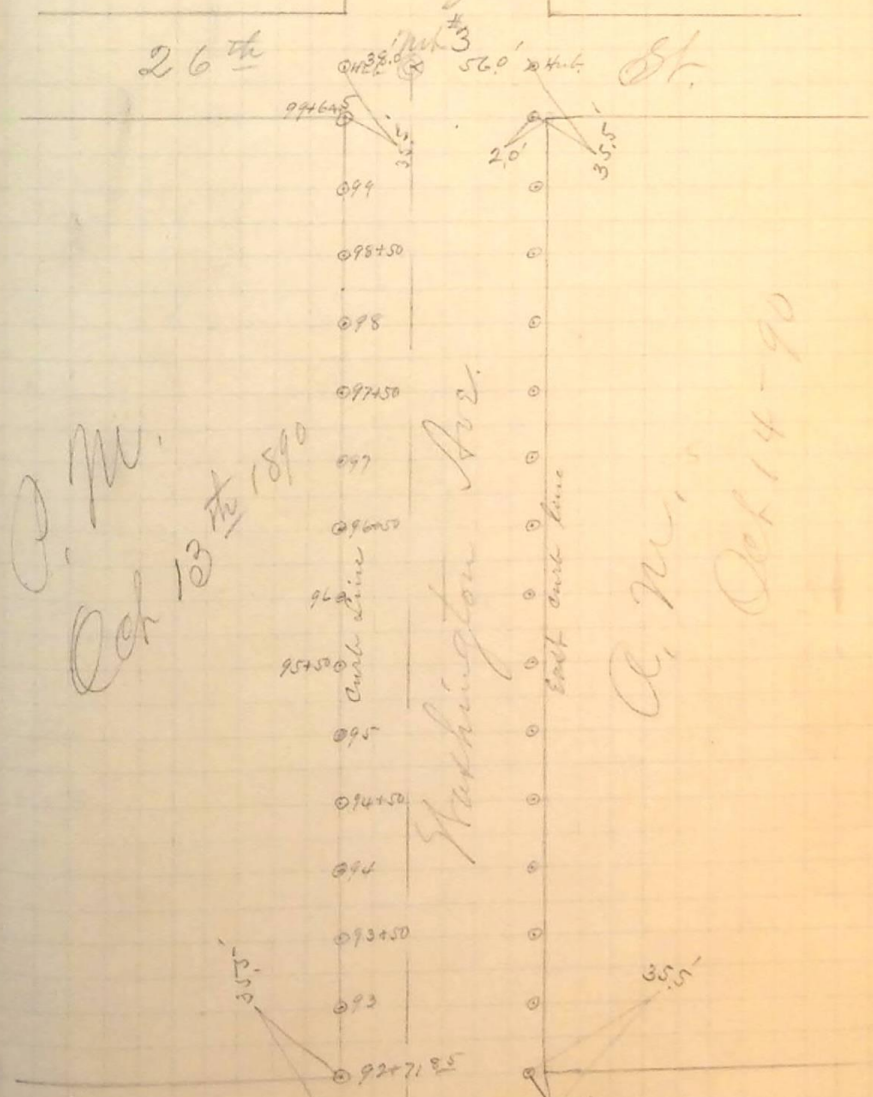

27th St @ mk #2

P. M.
Oct 13th 1890

A. M.
Oct 14-90