

For Elec Light Co


Set 3 stakes on curb line on West Curb Washington Ave on each block 26<sup>th</sup> to 27<sup>th</sup> and on 27<sup>th</sup> to 28<sup>th</sup> Sts.

A. M. Oct 15<sup>th</sup> 1890

Set hubs and stakes for curb grades on both sides Washington Avenue from 27<sup>th</sup> to 28<sup>th</sup> St. E. side hubs are set 4ft West of curb line and W side hubs are set 2ft East of curb line.

27<sup>th</sup>

St

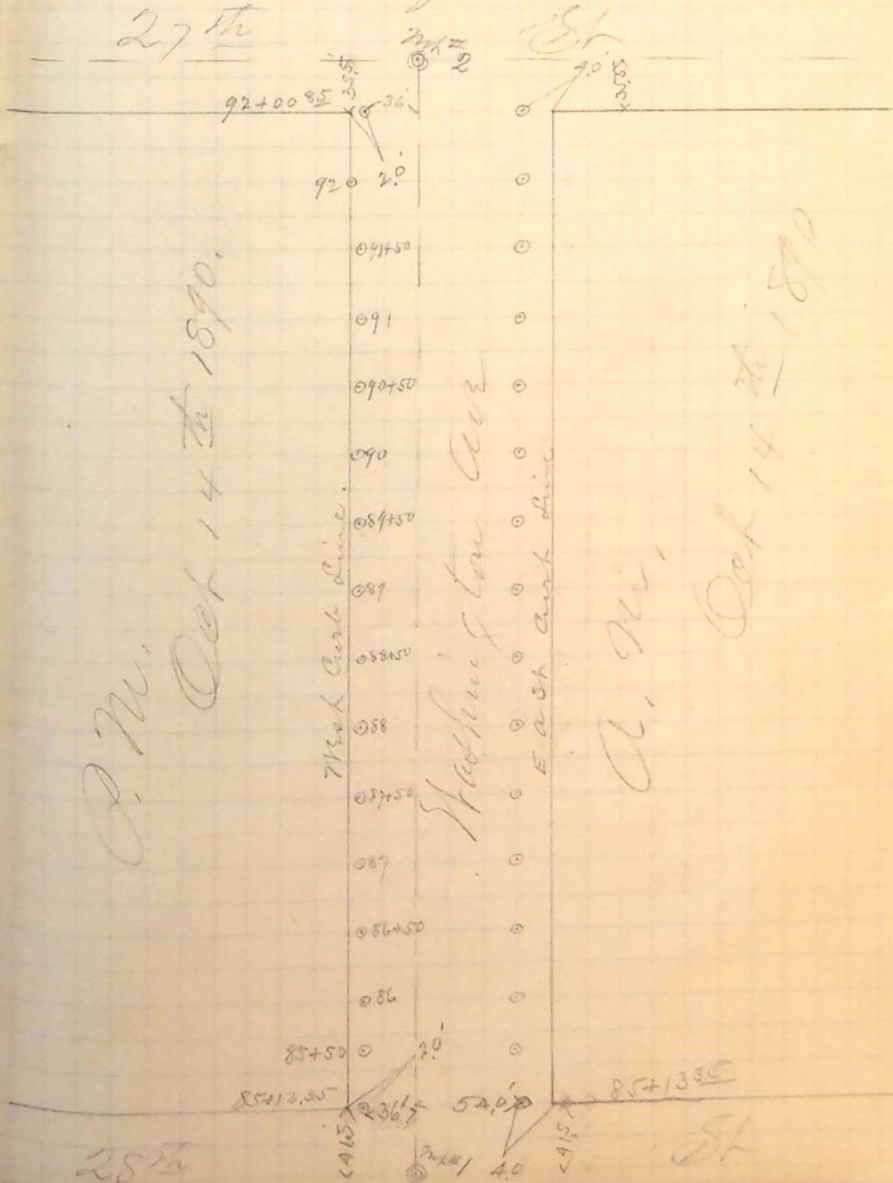


A. M. Oct 14<sup>th</sup> 1890

28<sup>th</sup>

St