


Topography Notes West Side
 West Abutment.

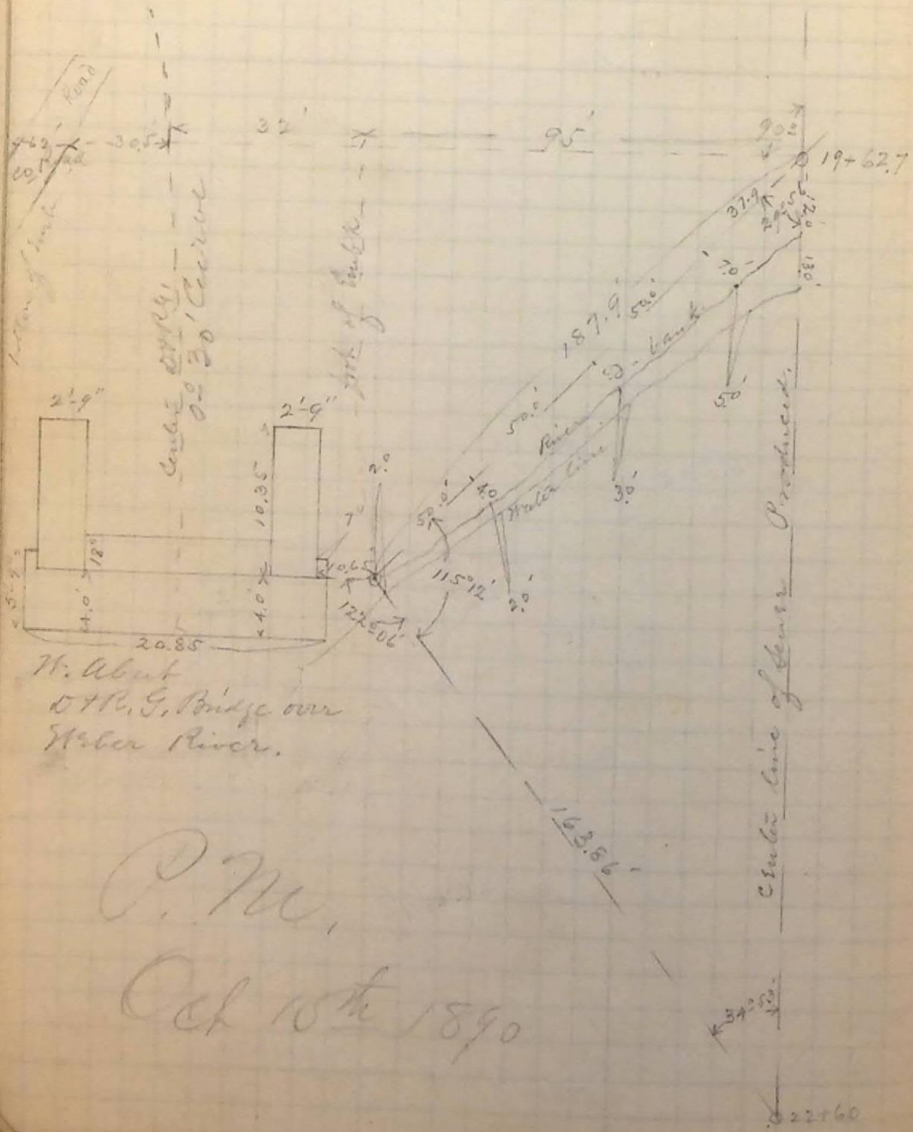

Topography Notes West Side⁶⁹
 West Abutment.

O. M. Oct 16th 90

