


Dimensions	Course	Dimensions	Course
2.33 x 2.58 x 1.0	6.02	2.42 x 1.17 x 1.0	2.86
1.25 x 1.17 x 1.0	1.46	6.5 x 2.17 x 1.0	14.10
4.25 x 1.95 x 1.0	7.44	2.83 x 1 1/3 x 1.0	3.77
3.92 x 1.5 x 1.0	5.88	1.67 x 3.5 x 1.0	5.85
2.33 x 1.83 x 1.0	4.27	2.08 x 1.75 x 1.0	3.64
1.5 x 2.67 x 1.0	4.01	1.67 x 2.17 x 1.0	3.62
1.08 x 1.0 x 1.0	1.08	0.67 x 1.25 x 1.0	0.84
4.0 x 1.0 x 1.0	4.00	3.58 x 1.5 x 1.0	5.37
2.67 x 1.5 x 1.0	4.01	3.67 x 2.17 x 1.0	7.96
2.42 x 3.5 x 1.0	8.47	2.58 x 2.75 x 1.0	7.10
4.75 x 1.0 x 1.0	4.75	Total	3116.60
3.75 x 1.67 x 1.0	6.26		938.87
2.58 x 1.5 x 1.0	3.87		4.32

Culyds.

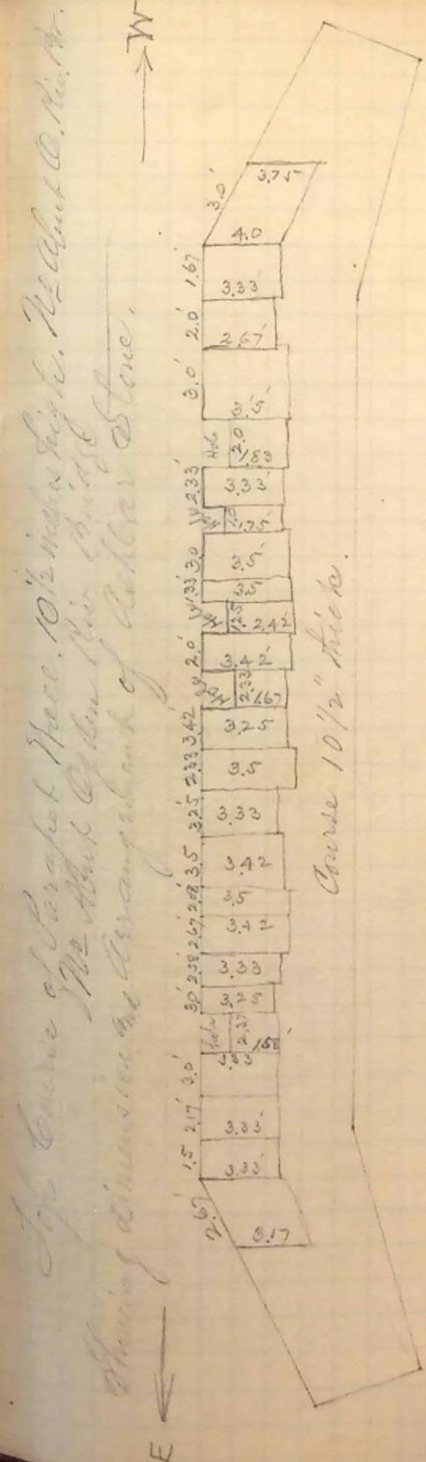

Dimensions	Course	Dimensions	Course
2.67 x 3.17 x 0.875	7.40	2.33 x 1.67 x 0.875	3.41
1.5 x 3 1/3 x 1.5	7.50	2.0 x 3.42 x 0.875	5.98
2.17 x 3 1/3 x 1.5	10.85	1.25 x 2.42 x 0.875	2.65
3.0 x 3 1/3 x 1.5	15.00	1 1/3 x 3.5 x 0.875	4.08
2.37 x 1.58 x 0.875	3.28	3.0 x 3.5 x 0.875	9.19
3.0 x 3.25 x 0.875	8.53	1.0 x 1.75 x 0.875	1.53
2.58 x 3 1/3 x 0.875	7.52	2 1/3 x 3 1/3 x 0.875	6.80
2.67 x 3.42 x 0.875	7.94	2.0 x 1.83 x 0.875	3.20
2.08 x 3.5 x 0.875	6.37	3.0 x 3.5 x 1.5	15.75
3.5 x 3.42 x 0.875	10.47	2.0 x 2.67 x 1.5	8.01
3.25 x 3 1/3 x 0.875	9.46	1.67 x 3 1/3 x 1.5	8.35
2.33 x 3.5 x 0.875	7.14	3.0 x 3.88 x 0.875	10.19
3.42 x 3.25 x 0.875	9.73	Total	190.40

7.05