Fourth Ward Cedar River Bridge. (Col 31-90)

Dimensions of Wing Dam & Work Station on Fishing Grounds - 16 "Height.


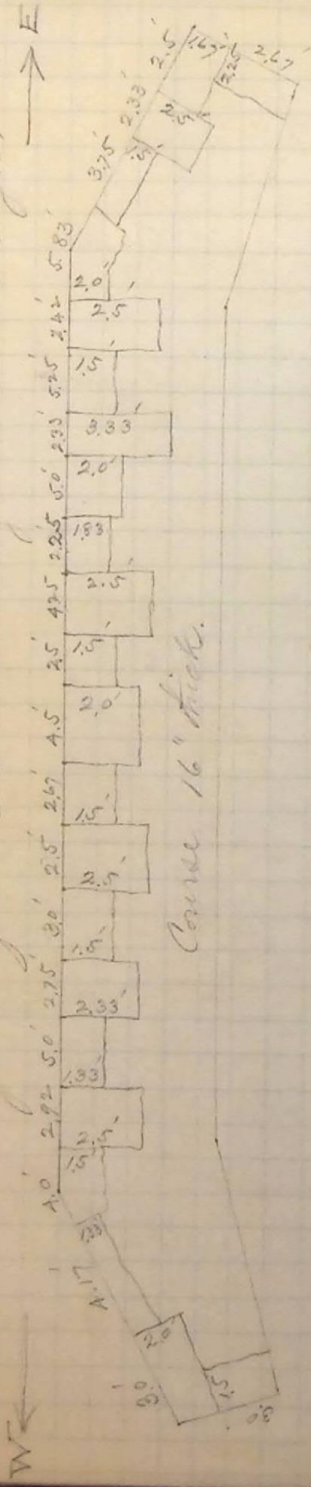

Dimensions.	Content	Dimensions	Content
3.0 × 1.5 × 1.33	5.98	2.25 × 1.83 × 1.33	5.748
3.0 × 2.0 × 1.33	7.98	5.0 × 2.0 × 1.33	13.33
4.17 × 1.33 × 1.33	7.38	2.33 × 3.33 × 1.33	10.34
4.0 × 1.5 × 1.33	7.98	5.25 × 1.5 × 1.33	10.50
2.92 × 2.5 × 1.33	9.71	2.42 × 2.5 × 1.33	8.05
5.0 × 1.33 × 1.33	8.84	5.83 × 2.0 × 1.33	15.55
2.75 × 2.33 × 1.33	8.52	3.75 × 1.5 × 1.33	7.49
3.0 × 1.5 × 1.33	5.98	2.33 × 2.5 × 1.33	7.77
2.5 × 2.5 × 1.33	8.31	2.5 × 1.67 × 1.33	5.56
2.67 × 1.5 × 1.33	5.33	2.25 × 2.67 × 1.33	8.00
4.5 × 2.0 × 1.33	11.97	Total. 3	111.20
2.5 × 1.5 × 1.33	4.99		66.40
4.25 × 2.5 × 1.33	14.12		7.40

Checking Dist between Mks #39 and #58.

B40

Made distance Measurement at 10 A. M. Nov 1st 1890 = 761.37 feet. Grant Ave 27th to 28th Streets.

Location 3rd Ward School House.

A. M.
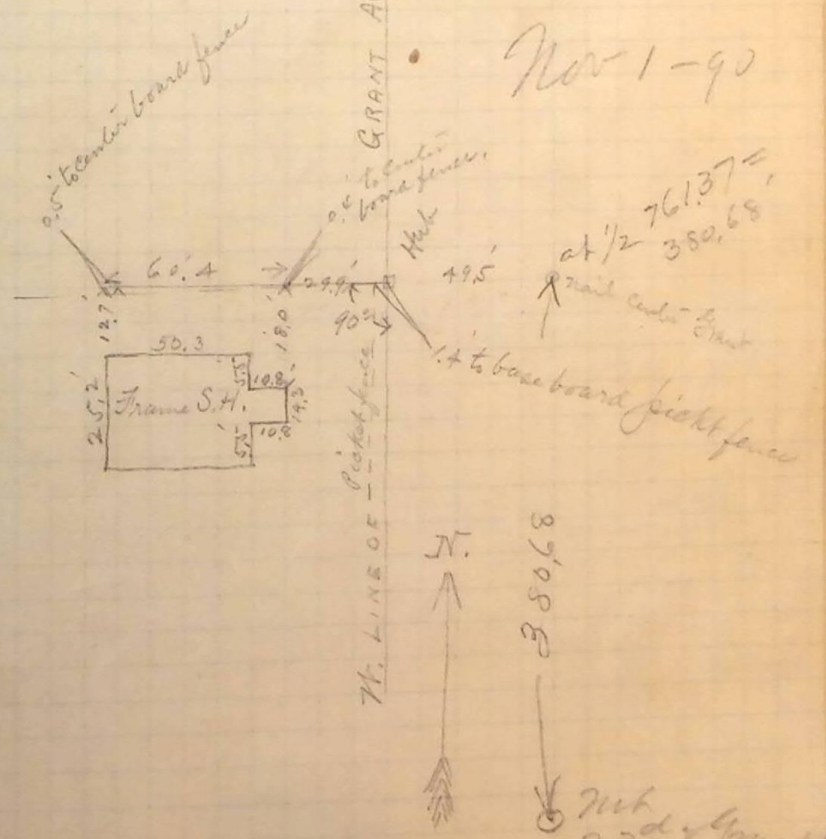
Nov 1-90