Measurements to Houses on Both Sides Wall Ave 22d to 23d Sts

Platted 22 B

A. M. Nov 13-90

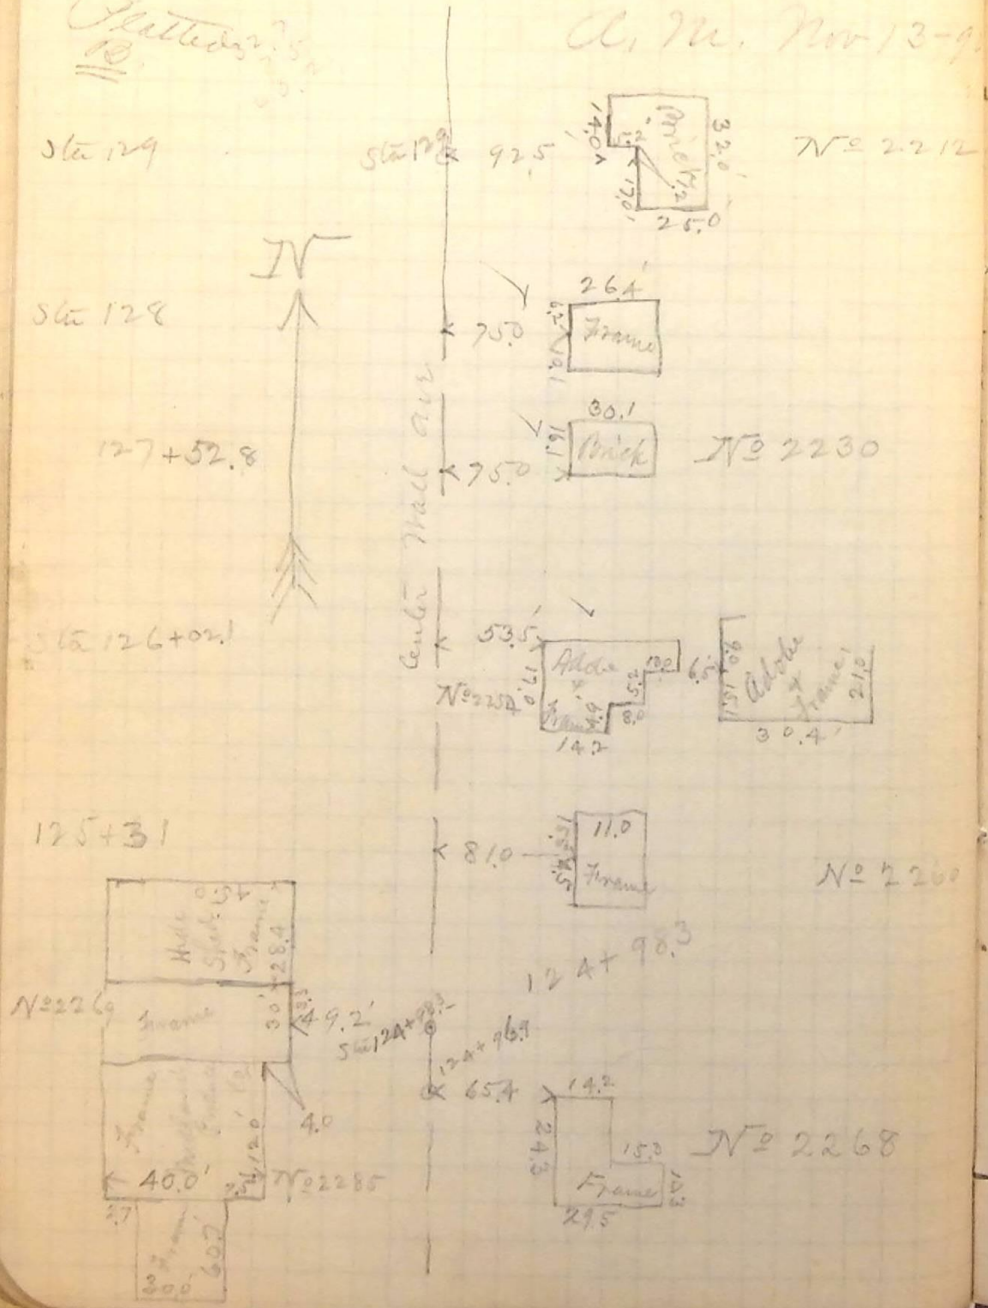

Measurements to Houses – 22d St. Wall Ave – East to Lincoln
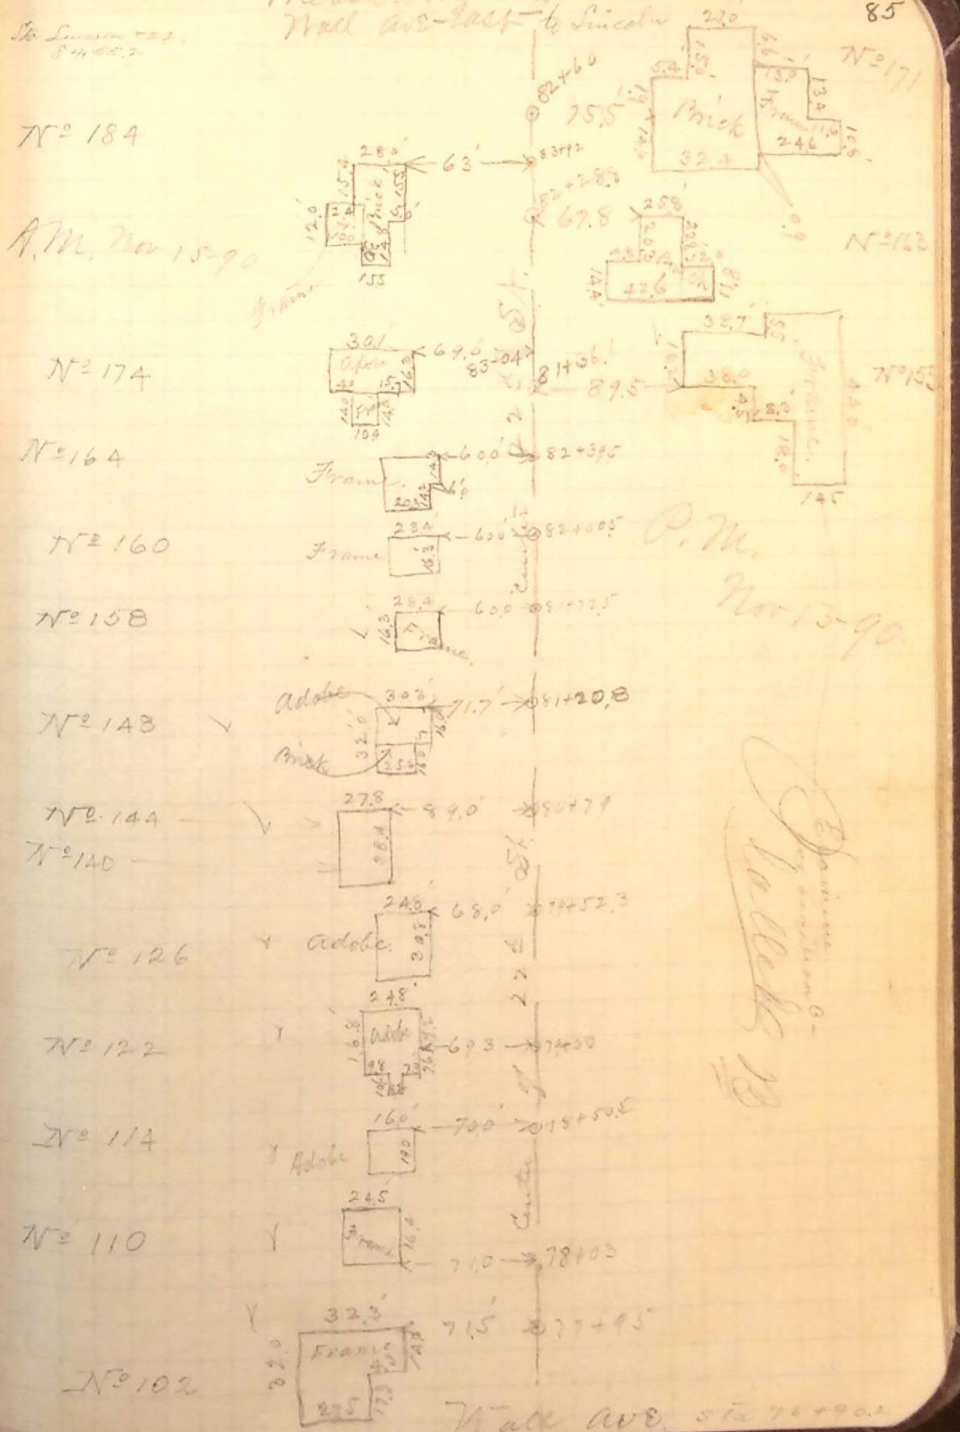
85