


Set Stakes for Electric Lights
on Washington Ave - North of Capitol
River -

Nov 18th 1890

With dust on offset line 10ft West of
Center, set

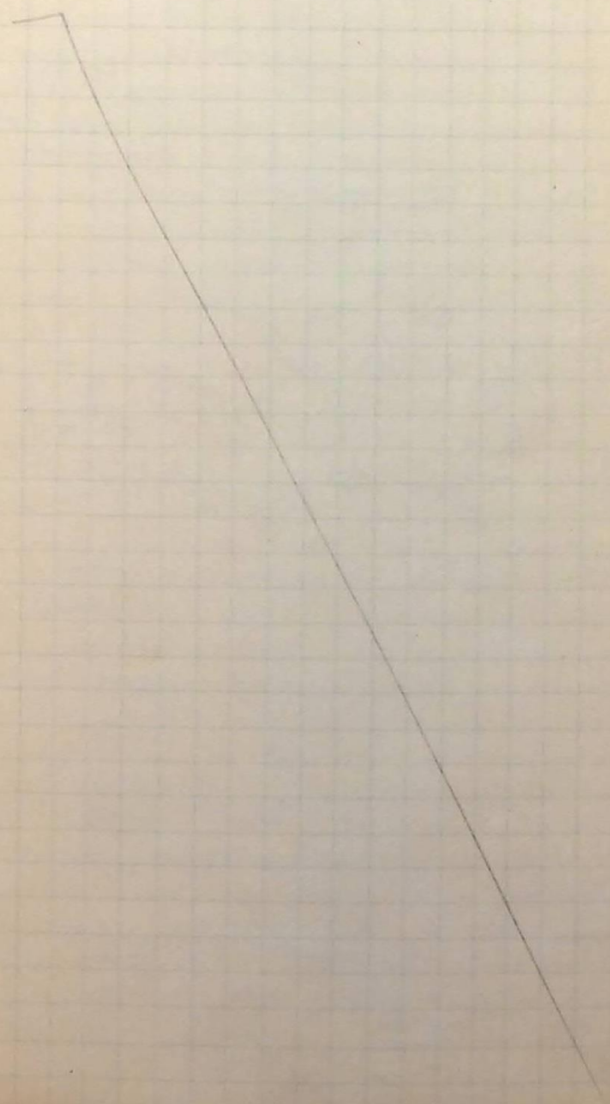

N ^o 35	230+50	α	48.0'	
N ^o 34	228			48.0' →
N ^o 33	226+50	α	48.0'	
N ^o 32	224+50			48.0' →
N ^o 31	222+50	α	48.0'	
N ^o 30	220+50			48.0' →
N ^o 29	218	α	48.0'	
N ^o 28	216			48.0' →
N ^o 27	214	α	48.0'	
N ^o 26	212			48.0' →
N ^o 25	210+25	α	48.0'	
N ^o 24	208			48.0' →
N ^o 23	206	α	48.0'	
N ^o 22	204			48.0' →
N ^o 21	202	α	48.0'	
N ^o 20	at 200			48.0' →

Washington Ave
Center

199+0122 center of 11th St Wash - Ave.

N ^o 19	at 198+00	α	38.0'	
N ^o 18	at 196+00			58.0' →
N ^o 17	at 193+70	α	38.0'	
N ^o 16	at 192+00			58.0' →
N ^o 15	at 190+25	α	38.0'	
N ^o 14	at 188+05			58.0' →
N ^o 13	at 186+00	α	38.0'	
N ^o 12	at 184+00			58.0' →
N ^o 11	at 181+80	α	38.0'	
N ^o 10	at 179+30			58.0' →
N ^o 9	at 176+00	α	38.0'	
N ^o 8	at 174+00			58.0' →
N ^o 7	at 172+00	α	38.0'	
N ^o 6	at 170+05			63.0' →
N ^o 5	at 168+00	α	36.0'	
N ^o 4	at 166+30			64.0' →
N ^o 3	at 164+00	α	34.0'	
N ^o 2	at 162+03			62.0' →
N ^o 1	at 159+60	α	34'	