


Get Lamb Grades, both sides *Smear*
Arc 27th to 28th St - *Every 50 feet*

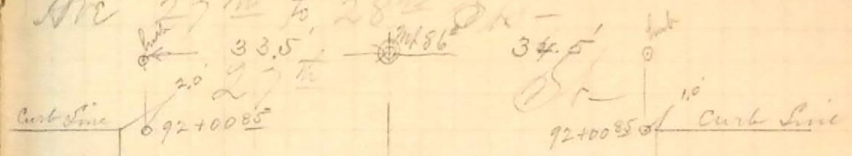


Curb Line.

Center Line of Lincoln Ave.

A.M. & Co. Application No. 1205
1590.

Curb Line

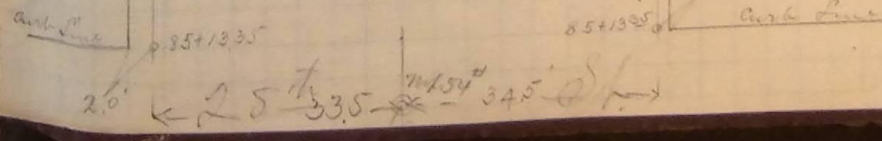


Curb Line