



Drift Abut. Glen River Bridge. Dec 5 to 1890
 Dimensional Arrangement of Cul. Stone in 1st Course abutting (24" high).

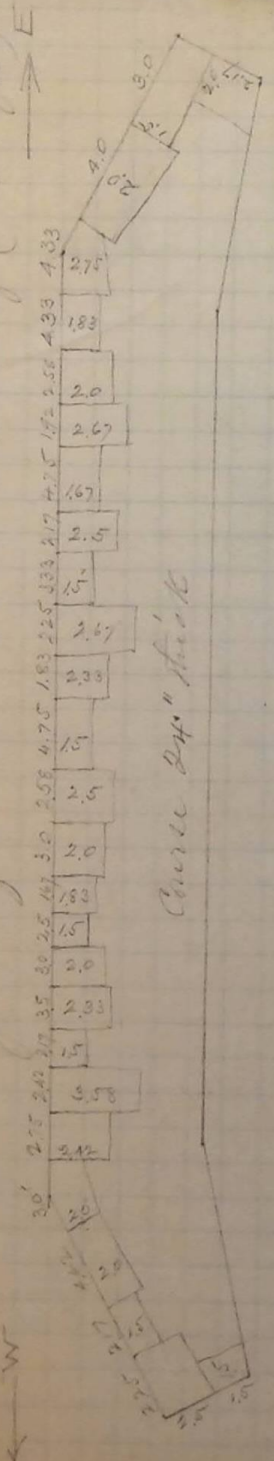

Course 24" thick

Dimensions	Cu feet	Dimensions	Weight	Dimensions	Weight
15 x 15 x 2.0	4.50	3.0 x 2.0 x 2.0	12.00	4.0 x 2.0 x 2.0	16.00
2.25 x 2.5 x 2.0	11.25	2.5 x 2.5 x 2.0	12.25	3.0 x 1.5 x 2.0	9.00
2.17 x 1.5 x 2.0	6.51	4.75 x 1.5 x 2.0	14.25	2.17 x 2.0 x 2.0	8.68
4.42 x 2.0 x 2.0	17.68	1.83 x 2.33 x 2.0	8.53	Total	321.33
3.0 x 2.0 x 2.0	12.00	2.25 x 2.67 x 2.0	12.02		9107.11
2.75 x 2.0 x 2.0	10.31	3.33 x 1.5 x 2.0	9.99		11.90
2.42 x 3.5 x 2.0	17.03	2.17 x 2.5 x 2.0	10.85		
2.17 x 2.5 x 2.0	6.51	4.75 x 1.75 x 2.0	15.87		
3.5 x 2.33 x 2.0	16.31	1.92 x 2.67 x 2.0	10.25		
3.0 x 2.0 x 2.0	12.00	2.5 x 2.0 x 2.0	10.32		
2.5 x 1.5 x 2.0	7.50	4.33 x 1.83 x 2.0	15.85		
1.67 x 1.83 x 2.0	6.11	4.0 x 2.75 x 2.0	23.81		

26th

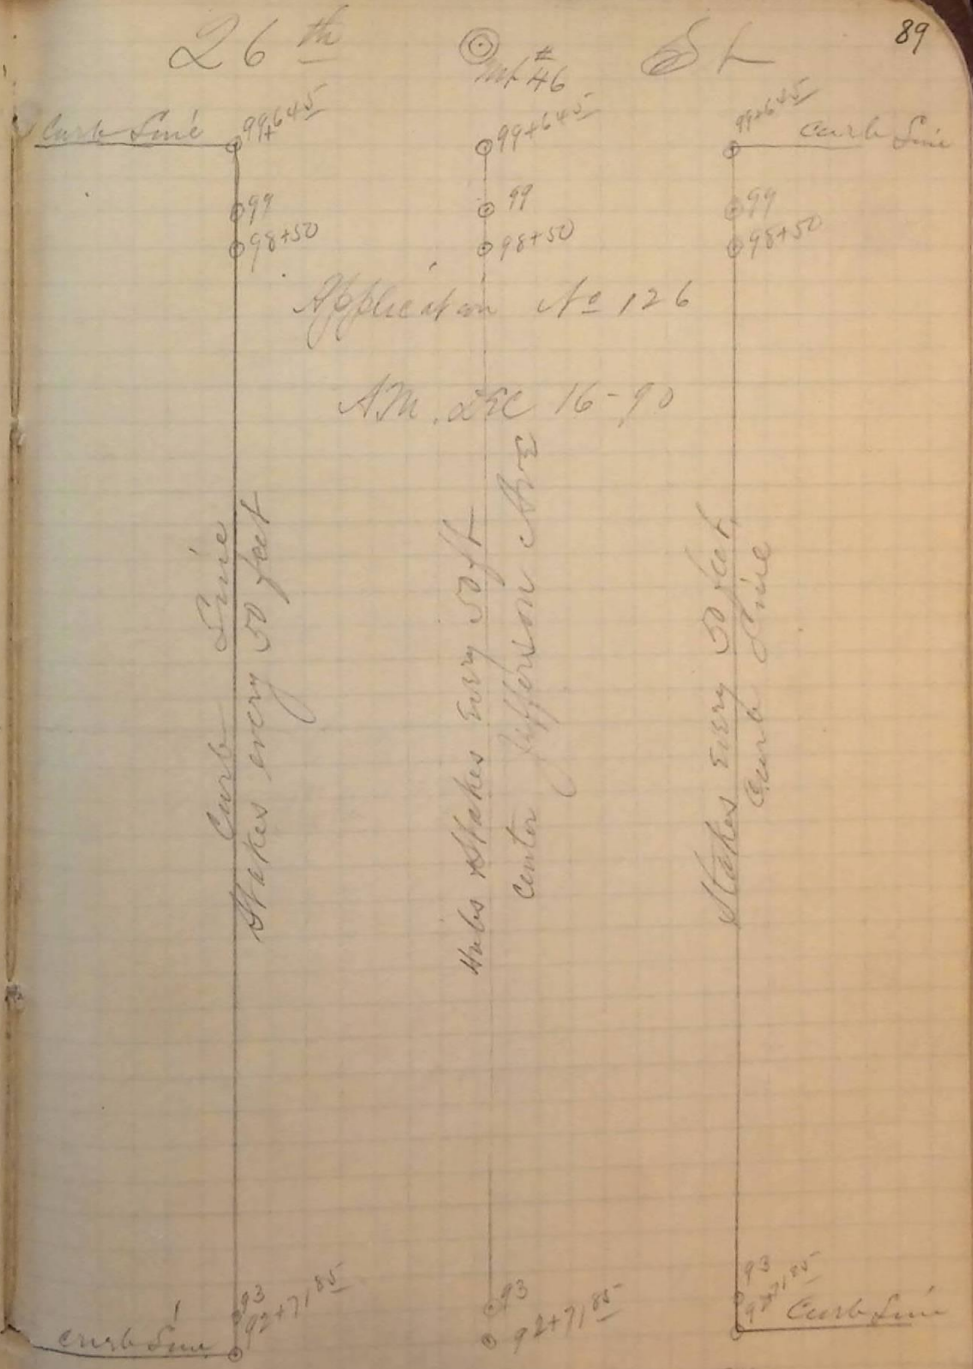

Application No 126

Am. Dec 16-90

Curb Line
 Stakes every 50 feet

Hubs stakes every 50 ft
 center Jefferson Ave

Stakes every 50 feet
 curb line



