


Course About Cylindrical Bridge
 Dimensions and Arrangement of Cut Stone in 2nd Course of Facing (24" high)

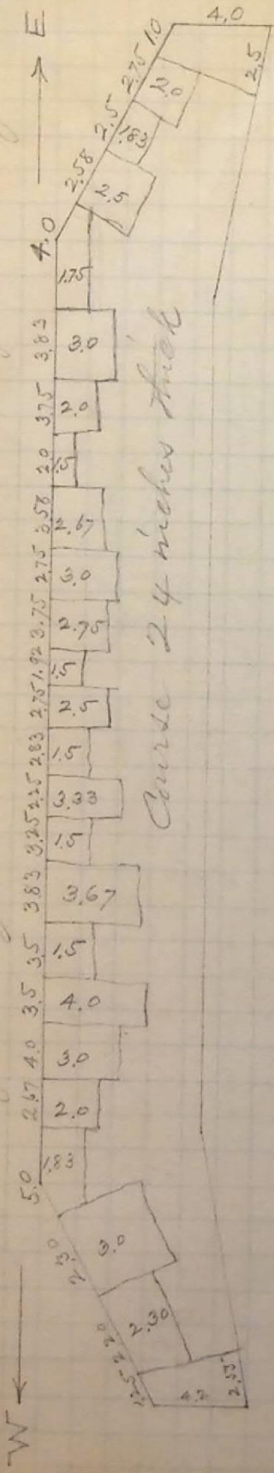


Course 24 inches thick

Dimensions	Cu. Feet	Dimensions	Cu. Feet	Dimensions	Cu. Feet
1.9 x 4.2 x 2.0	15.96	1.92 x 1.5 x 2.0	5.76		
2.2 x 2.9 x 2.0	10.12	3.75 x 2.75 x 2.0	20.62		
2.3 x 3.0 x 2.0	13.80	2.75 x 3.0 x 2.0	16.50		
5.0 x 1.83 x 2.0	18.30	3.58 x 2.67 x 2.0	19.12		
2.67 x 2.0 x 2.0	10.68	2.0 x 1.5 x 2.0	6.00		
4.0 x 3.0 x 2.0	24.00	3.75 x 2.0 x 2.0	15.00		
3.5 x 4.0 x 2.0	28.00	3.83 x 3.0 x 2.0	22.98		
3.5 x 1.5 x 2.0	10.50	4.0 x 1.75 x 2.0	14.00		
3.83 x 3.67 x 2.0	28.10	2.75 x 2.5 x 2.0	12.90		
3.25 x 1.5 x 2.0	9.75	2.5 x 1.83 x 2.0	9.15		
2.25 x 3.33 x 2.0	14.99	2.75 x 2.0 x 2.0	11.00		
2.83 x 1.5 x 2.0	8.49	1.75 x 4.0 x 2.0	14.00		
2.75 x 2.5 x 2.0	13.75	Total	378.47		
			124.48		
			13.83		

cu. ft.

Course About Cylindrical Bridge

Dimensions and Arrangement of Cut Stone in Facing Course - Course 18 inches thick

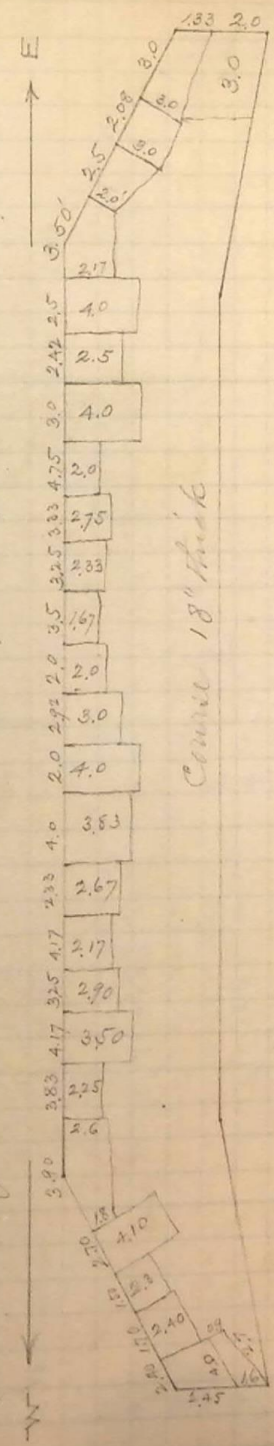

Course 18" thick

Dimensions	Cu. Feet	Dimensions	Cu. Feet	Dimensions	Cu. Feet
1.5 x 2.7 x 1.5	5.06	2.0 x 1.0 x 1.5	12.00	2.08 x 3.0 x 1.5	9.36
3.2 x 2.45 x 1.5	11.76	2.92 x 3.0 x 1.5	13.14	3.0 x 2.7 x 1.5	9.76
1.7 x 2.4 x 1.5	6.12	2.0 x 2.0 x 1.5	6.00	3.0 x 2.0 x 1.5	9.00
1.5 x 2.3 x 1.5	5.18	3.5 x 1.67 x 1.5	8.77	Total	32.19
2.7 x 4.1 x 1.5	16.60	3.25 x 2.33 x 1.5	11.36		35.79
3.9 x 2.0 x 1.5	12.87	3.33 x 2.75 x 1.5	13.74		11.93
3.83 x 2.25 x 1.5	12.93	4.75 x 2.0 x 1.5	14.25		
4.17 x 3.5 x 1.5	21.89	3.0 x 4.0 x 1.5	18.00		
4.25 x 2.9 x 1.5	14.14	2.42 x 2.5 x 1.5	9.08		
4.17 x 2.7 x 1.5	13.25	2.5 x 4.0 x 1.5	15.00		
2.83 x 2.67 x 1.5	9.33	3.5 x 2.08 x 1.5	10.92		
4.0 x 3.83 x 1.5	22.98	2.5 x 2.5 x 1.5	9.38		

SEE 17-1890