Dec 18th 1890.

South Abut
Ogden River Bridge
Size and Arrangement of Cut Stone in 1st Course of Parapet Wall. Course 12" thick.

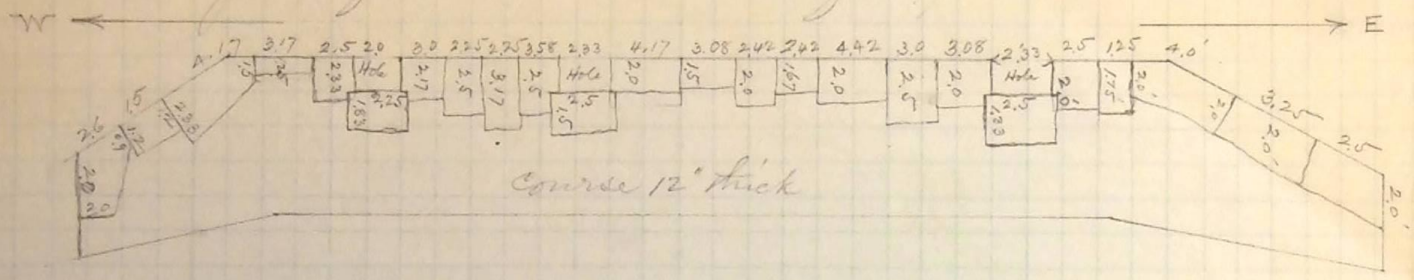

Dimensions	Cu Feet	Dimensions	Cu Feet	Dimensions	Cu Feet
2.3 × 2.0 × 1.0	4.60	3.58 × 2.5 × 1.0	8.95	2.5 × 1.33 × 1.0	3.33
1.5 × 1.2 × 1.0	1.80	2.5 × 1.5 × 1.0	3.75	2.5 × 2.0 × 1.0	5.00
4.17 × 1.92 × 1.0	8.01	4.17 × 2.0 × 1.0	8.34	1.25 × 1.75 × 1.0	2.19
3.17 × 1.25 × 1.0	3.96	3.08 × 1.5 × 1.0	4.62	4.0 × 2.0 × 1.0	8.00
2.5 × 2.33 × 1.0	5.83	2.42 × 2.0 × 1.0	4.84	3.25 × 2.0 × 1.0	6.50
2.75 × 1.83 × 1.0	4.12	2.42 × 1.67 × 1.0	4.04	2.5 × 2.0 × 1.0	5.00
3.0 × 2.17 × 1.0	6.51	4.42 × 2.0 × 1.0	8.84	9	134.64
2.25 × 2.5 × 1.0	5.62	3.0 × 2.5 × 1.0	7.50	3	14.96
2.25 × 3.17 × 1.0	7.13	3.08 × 2.0 × 1.0	6.16		4.99 Cu Yds.

Dec 19th 1890

South Abut
Ogden River Bridge
Size and Arrangement of Cut Stone in 2d Course of Parapet Wall. Course 12" thick.

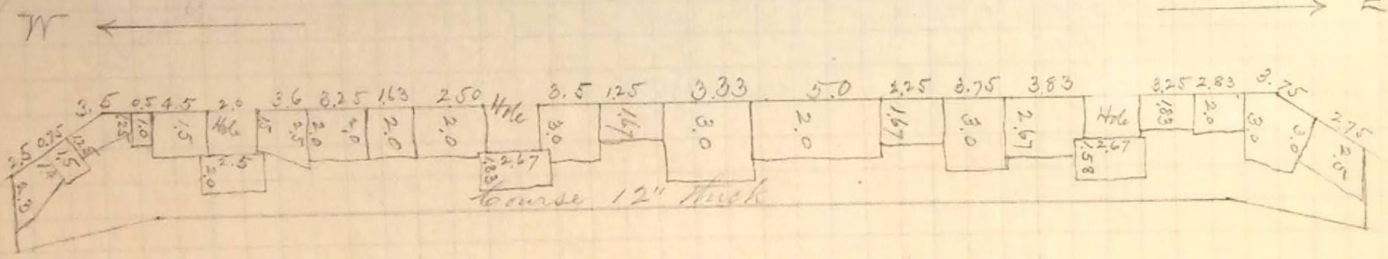

Dimensions	Cu Feet	Dimensions	Cu Feet	Dimensions	Cu Feet
2.5 × 1.85 × 1.0	4.63	1.25 × 1.67 × 1.0	2.09		
0.75 × 1.5 × 1.0	1.13	3.33 × 3.0 × 1.0	9.99		
3.5 × 1.25 × 1.0	4.38	5.0 × 2.0 × 1.0	10.00		
0.5 × 1.0 × 1.0	0.50	2.25 × 1.67 × 1.0	3.76		
1.5 × 1.5 × 1.0	6.75	3.75 × 3.0 × 1.0	11.25		
2.5 × 2.0 × 1.0	5.00	3.83 × 2.67 × 1.0	10.23		
3.6 × 2.0 × 1.0	7.20	2.67 × 1.58 × 1.0	4.22		
3.25 × 2.0 × 1.0	6.50	3.25 × 1.83 × 1.0	5.95		
1.63 × 2.0 × 1.0	3.26	2.83 × 2.0 × 1.0	5.66		
2.5 × 2.0 × 1.0	5.00	3.75 × 3.0 × 1.0	11.25		
2.67 × 1.83 × 1.0	4.89	2.75 × 2.5 × 1.0	6.88		
3.5 × 3.0 × 1.0	10.50	Total	3 141.02		
			47.00		
			5.22 Cu Yds		