


Dec 19th 1890

South Abut

Cylinder Over Bridge.
 Course 14 "thick
 Except where otherwise noted.

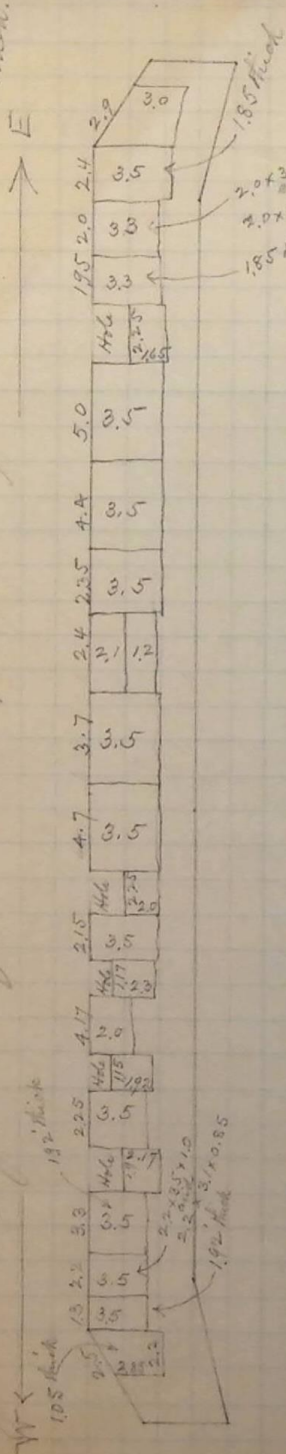


Dimensions	Cu Feet	Dimensions	Cu Feet	Dimensions	Cu Feet
2.85 x 2.35 x 1.05	7.03	4.7 x 3.5 x 1.17	19.25	2.9 x 3.0 x 1.17	10.18
1.3 x 3.5 x 1.92	8.74	3.7 x 3.5 x 1.17	15.15	Total 3	240.36
2.2 x 3.1 x 0.85	5.86	2.1 x 2.4 x 1.17	5.89	1.9	80.12
2.2 x 3.5 x 1.0	7.70	2.4 x 1.2 x 1.17	3.37	8.90	
3.8 x 3.5 x 1.92	22.18	2.35 x 3.5 x 1.17	9.62		
1.9 x 2.17 x 1.17	4.82	4.4 x 3.5 x 1.17	18.02		
2.25 x 3.5 x 1.17	9.21	5.0 x 3.5 x 1.17	20.48		
1.15 x 1.92 x 1.17	2.58	2.25 x 1.65 x 1.17	4.34		
4.17 x 2.0 x 1.17	9.76	1.95 x 3.3 x 1.85	11.90		
1.17 x 2.3 x 1.17	3.15	2.0 x 3.3 x 1.0	6.60		
2.15 x 3.5 x 1.17	8.80	2.0 x 3.0 x 0.83	4.98		
2.25 x 2.0 x 1.17	5.27	2.4 x 3.5 x 1.85	15.54		

808 Cyfs retained in
 Finest Dec 19-90 in-
 clud of 8.90 - the mis-
 take occurring in leaving
 out stone in West end
 3.3 x 3.5 x 1.92

Final Estimate of Superficial Feet.

Stone dressed (copying bridge cut) in
 both Abutments Cyden River Bridge

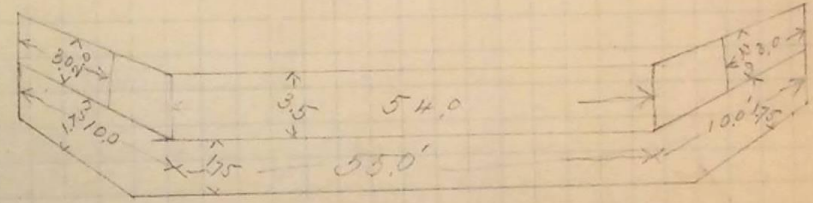

Bridge Seat 55.0 x 1.75 x 2 = 192.5
 Coping, King. 10.0 x 1.75 x 4 = 70.0
 Coping " 3.0 x 2.0 x 4 = 24.0
 Parapet 54.0 x 3.5 x 2 = 378.0
 Total 664.5 x 1.25 = 830.62

Returned Dec 19th 1890