


Location and Elevation of 4" Gas Main on
23^d St. East of Center of Lincoln Ave

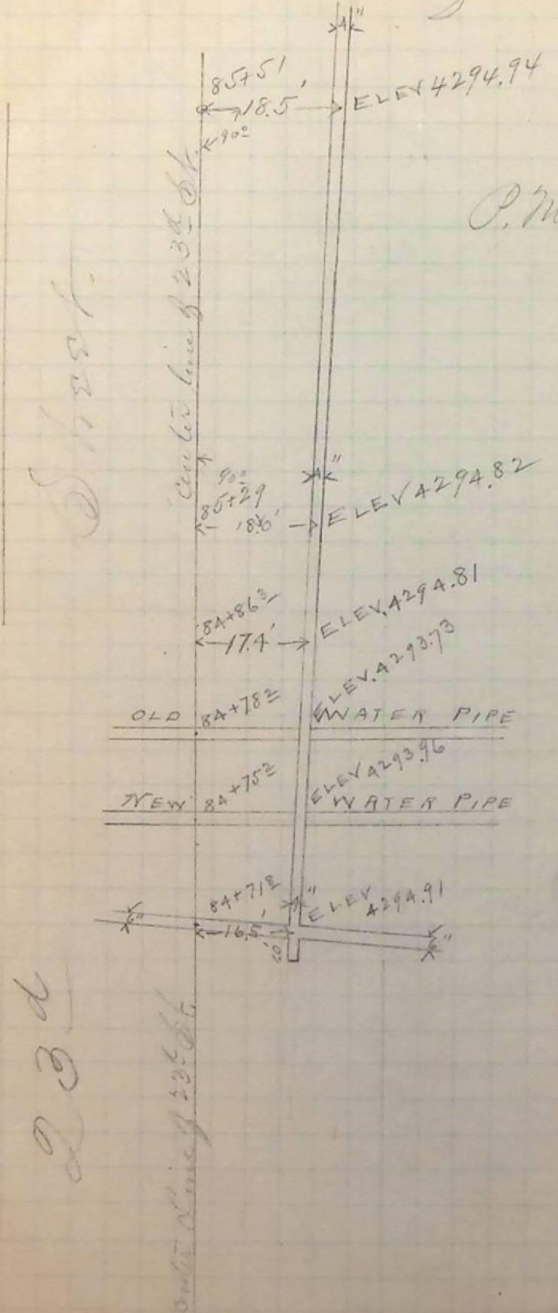

P.M. Nov 20-90

Location and Elevations of Gas
Water Pipes on 22^d St. E. of Center of Lincoln
Ave.

A.M.
Nov 29-90.

