


Measurements to and dimensions of
Buildings on Wall Ave
23rd to 24th St.

P. M.
Dec 27-90

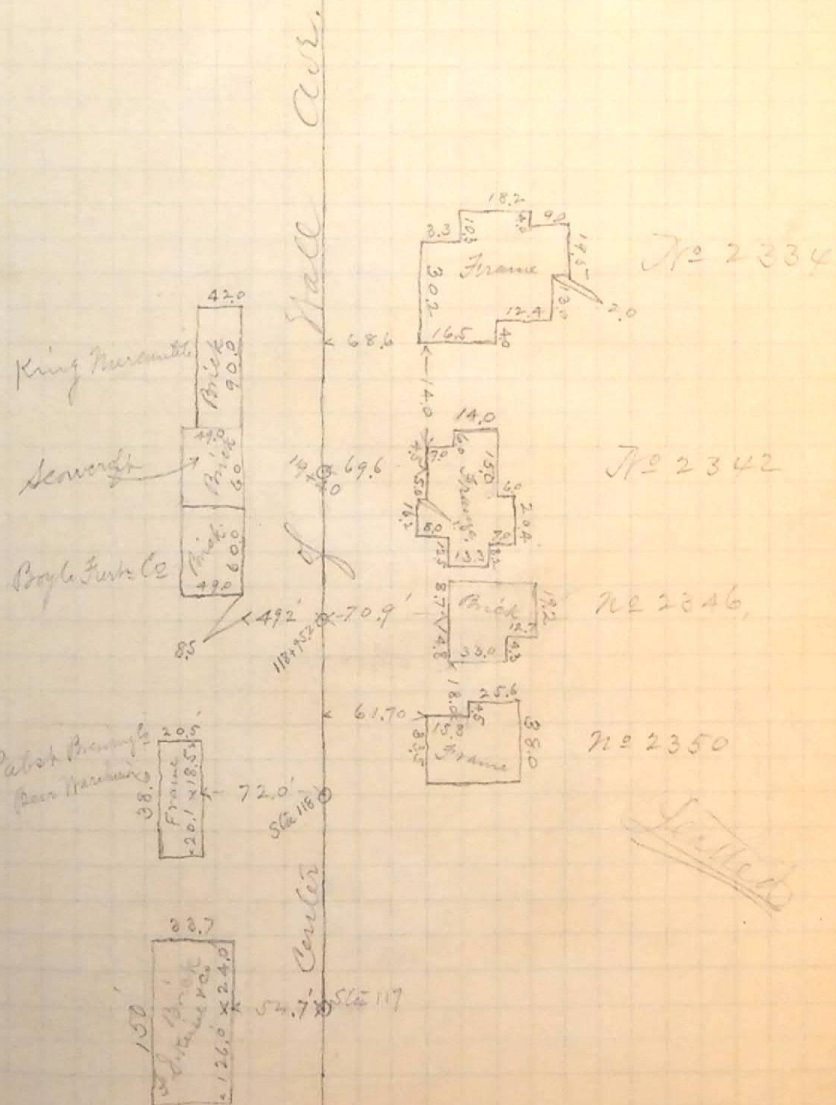

24th St.