


Measurements to and
 dimensions of houses on Wall Ave,
 25th to 26th P.M.,
 Dec 27-90

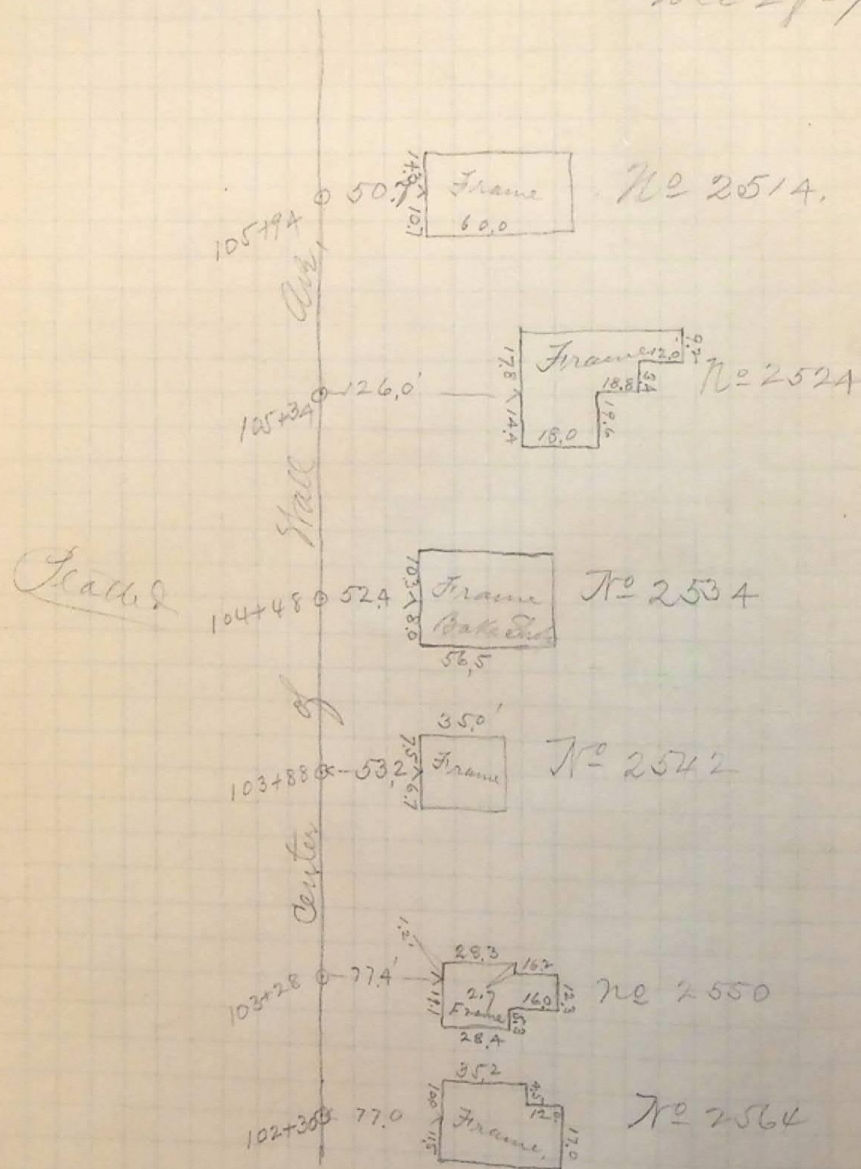

26th St.

Measurements to and
 dimensions of buildings on
 Wall Ave - 26th to 27th Sts. 2