


Measurements to and Dimensions of
Houses on 22^d St. Grant to Wash Ave
A. M. Jan 2-91

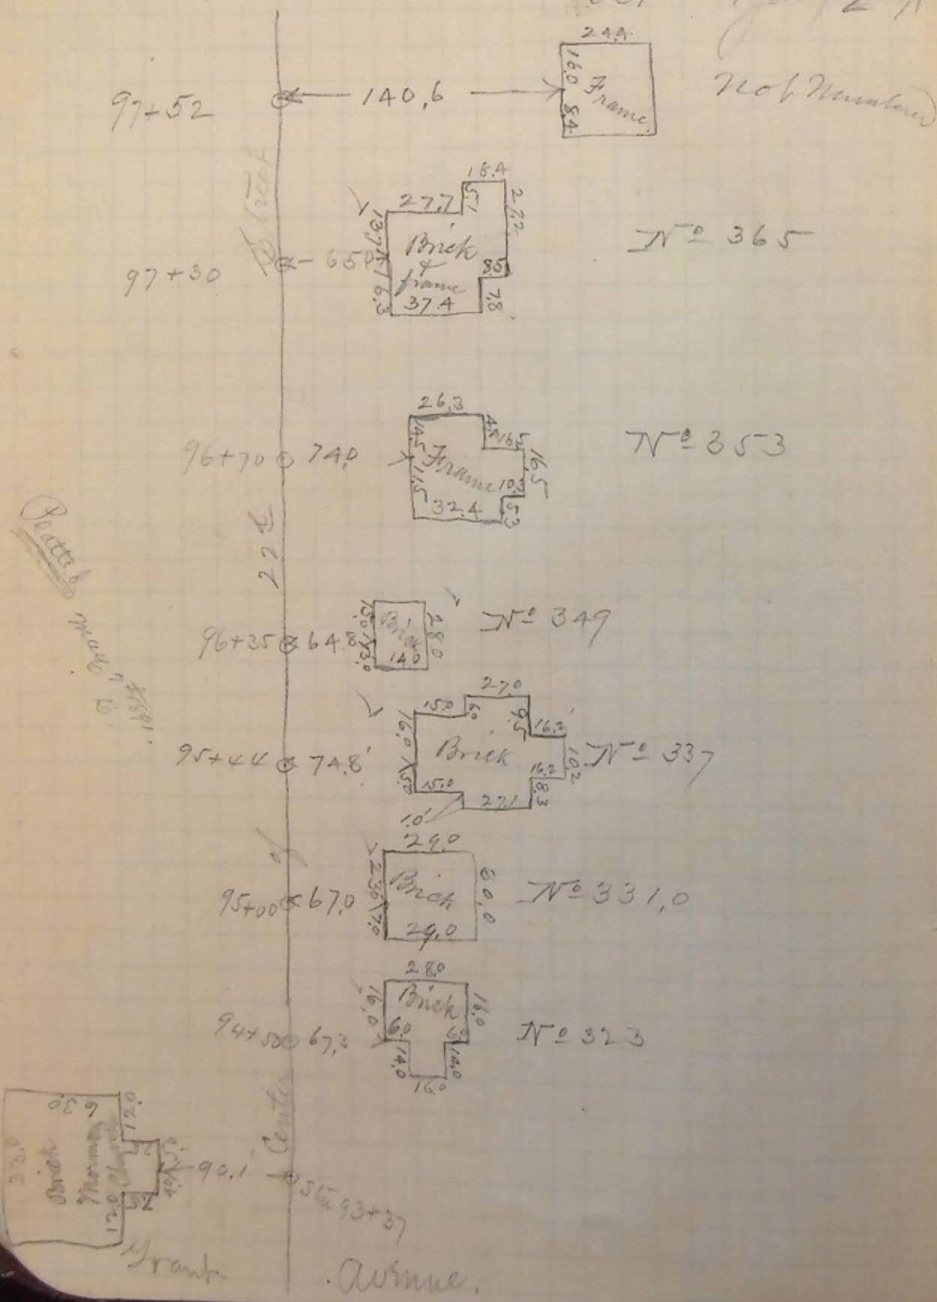

Location and Elevation of old
Water Pipe at Lincoln Ave
24th St.

